




RECEIVED

NOV 08 2021

OWRD

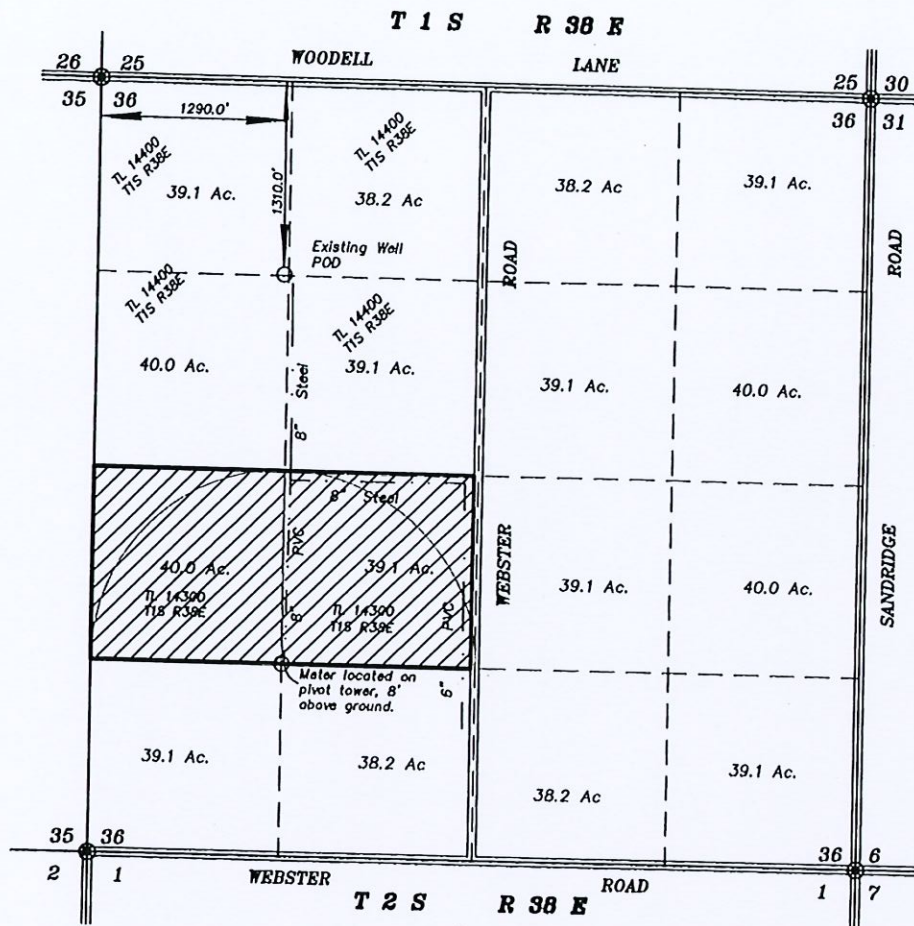

SCALE: 1"=1320'

GPS POSITION OF WELL

45°26'18.76601" N
118°00'33.00359" W


Actual GPS tie to the existing well # 173 found to be South 1310.0' and East 1290.0' from NW Corner of Northwest Corner of Section 36.

The original tie shows the Well at S 1320' and East 1290' from NW corner of Section 36. Original tie was prior to setting County monuments at the true corners.

- Found monumented corner as per Union County Survey Records.



Lands irrigated from well under Permit G-16963

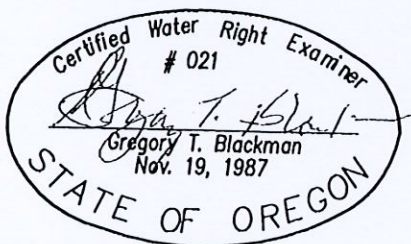

MAY 4, 2016

**CLAIM OF BENEFICIAL USE MAP FOR
UNDER PERMIT NUMBER G-16963**

FOR
TODD ARNOLDUS
BY

BAGETT - GRIFFITH & BLACKMAN
126 RIDGE DRIVE

LAGRANDE, OREGON 97850

Application No. G-17508

Permit Number G-16963

NOTE: The preparation of this map was for the purpose of identifying the location of the proposed water right and has no intent to provide dimensions or location of property ownership lines. Location information shown hereon was furnished by the applicant.