

GROUND WATER REGISTRATION MODIFICATION


CHANGE IN PLACE OF USE AND POINT OF APPROPRIATION

REGISTRATION GR-4090 CERTIFICATE GR-3860

Section 9, Township 38 South, Range 7 West, W.M.



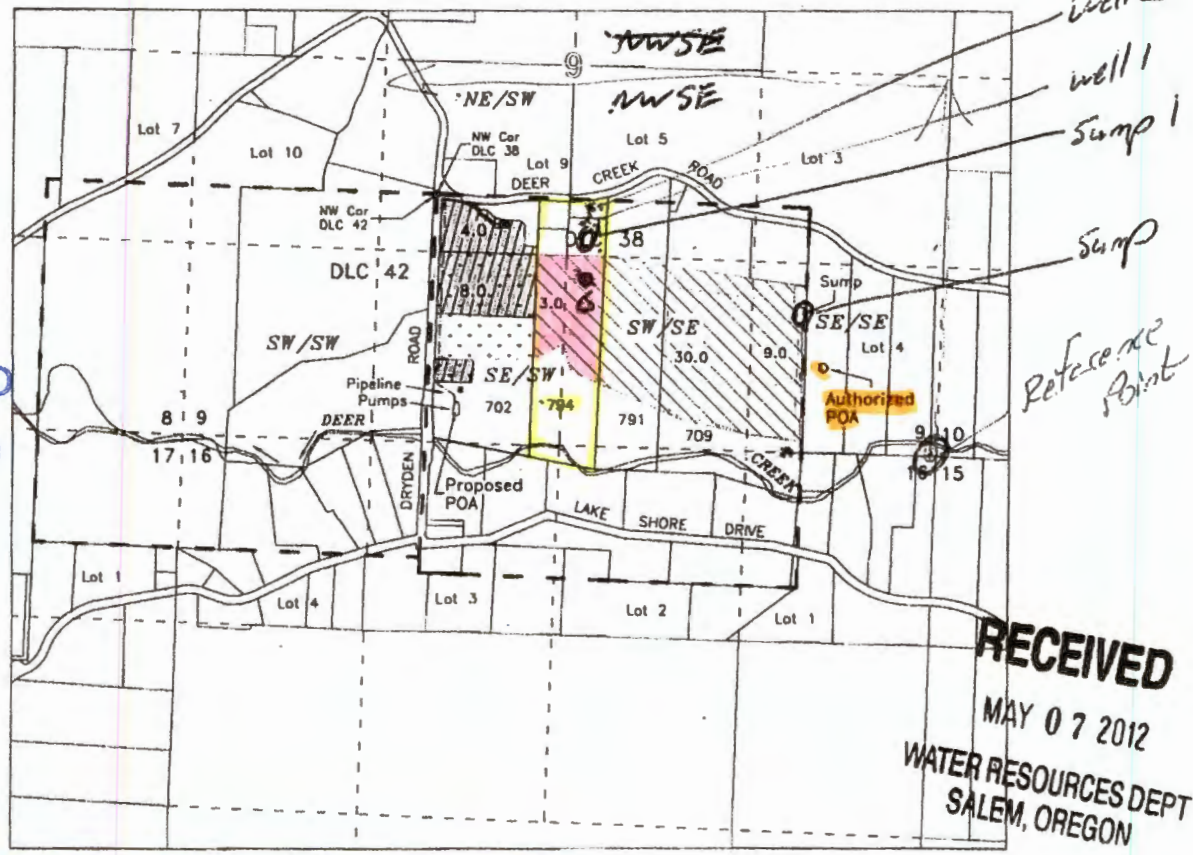

Josephine County, Oregon

RECEIVED
OCT 06 2021
OWRD



RECEIVED
MAY 07 2012
WATER RESOURCES DEPT
SALEM, OREGON

- o AUTHORIZED POINT OF APPROPRIATION (Sump) SE-SE, 590 feet North & 810 feet West from the SE Corner Section 9, T.38S, R.7W, W.M. (not in use)
- o PROPOSED POINT OF APPROPRIATION (Sump) SE-SW, 230 feet North & 3390 feet West from the SE Corner Section 9, T.38S, R.7W, W.M. (12.0 ac. TL-702 only) (Was constructed in 1982 or 1983)

<p>IRRIGATION - JUNE 1948</p>	<p>APPLICANT:</p>	
<p>  Assumed original place of use Not modified by this application 42.0 ac.* (No Official Map Available) <i>portion to be assigned</i> </p> <p>  Change in Place of Use Before Change - 12.0 ac. SE-SW Section 9 </p> <p>  Change in Place of Use After Change - 4.0 ac. NE-SW 8.0 ac. SE-SW Section 9 </p>	<p> <i>James R. & Leona M. LaFlamme</i> <i>P.O. Box 106</i> <i>Selma, OR 97538-0106</i> </p> <p> *Of the remaining 42.0 acres after this change, only about 20.0 acres have been and are being irrigated, all on TL-709. </p> <p> Rate of diversion in registration is 150 gpm for 54 acres with a total duty of 100 Acre-Feet </p> <p> Upon adjudication, if fewer than 54 acres are found irrigated, it is expected that the total quantity of water (150 gpm) not be reduced unless the rate per acre exceeds 1/80 CFS per acre and the duty of 100 Acre-Feet not be reduced unless it exceeds 2.5 acre feet per acre </p>	<p>  </p> <p> Scale 1 inch = 1320 feet </p>
<p>This map is not intended to provide legal dimensions or locations of property ownership lines</p>	<p>Base Map: Josephine County GIS data with 2005 FSA aerial photo overlay for assumed best fit</p>	<p>Rev. 4/26/2012 n.s.d.</p>