

~~RECEIVED BY OWRD~~

~~DEC 21 2017~~

~~SALEM, OR~~

Ben Beck and Sarah Sibbernsen
~~Alternate Reservoir Application~~
 38S-2W-7 TL 602 SWNW
 Irrigation not to exceed 6 acres in SWNW

Reference Corner

POORMAS CREEK

RECEIVED

NOV 18 2021

OWRD

Legend

TL 602


POD Poormas Creek Pond:

Pond

Poormas Creek POD:
 1242 ft West and
 1270 ft South from Center of NW
 Corner Section 7

Pond:
 1150 West and
 1206 ft South from Center of
 NW Corner Section 7

1 inch = 500 feet

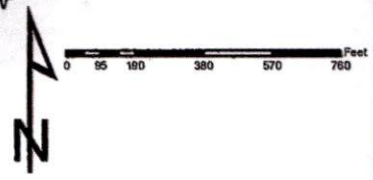

JACKSON COUNTY
WATERMASTER

Prepared by Shavon Haynes

This map is based on a digital database compiled by Jackson County from a variety of sources. Jackson County cannot accept responsibility for errors, omissions, or positional accuracy. There are no warranties, expressed or implied.

Date: 10/05/2017, 38S-2W-7-tax lot 602 Ben Beck.mxd, haynes

R-00007