



SE 1/4 OF THE SW 1/4 OF SECTION 25
 SW 1/4 OF THE SE 1/4 OF SECTION 25
 T1S & R3E OF THE WM
 CLACKAMAS COUNTY, OREGON

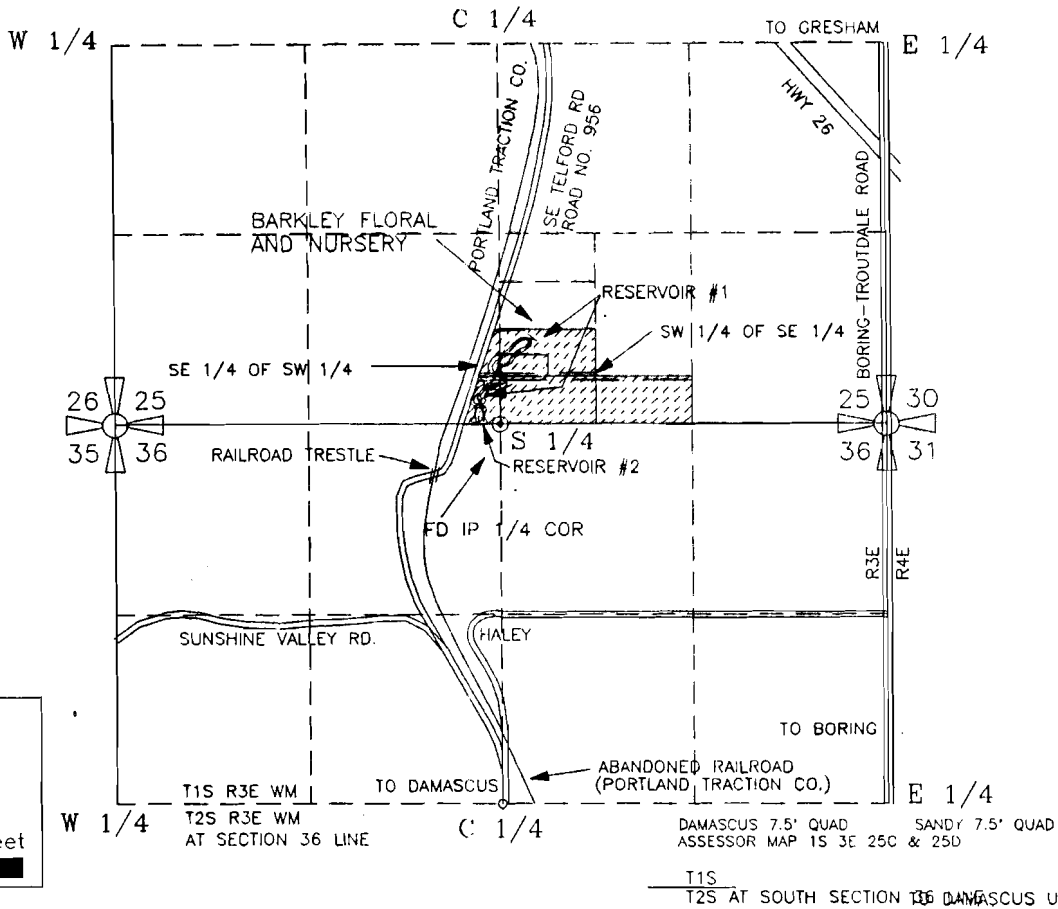

RESERVOIR SURFACE AREA & VOLUME

RESERVOIR #1:
 SURFACE AREA = 99,100 SQ FT (2.275 AC)
 MAXIMUM VOLUME = 376,795 CF (8.650 AC FT)
 RESERVOIR #2:
 SURFACE AREA = 15,550 SQ FT (0.357 AC)
 MAXIMUM VOLUME = 141,375 CF (3.25 AC FT)

RESERVOIR #1 DAM IS LOCATED 590' NORTH & 215' EAST
 RESERVOIR #2 DAM IS LOCATED 250' NORTH & 85' EAST OF
 THE SOUTH 1/4 CORNER OF SECTION 25, BOTH STORAGE
 RESERVOIRS BEING LOCATED IN THE SOUTH 1/2 OF
 SECTION 25, T1S, R3E WM, CLACKAMAS COUNTY, OREGON

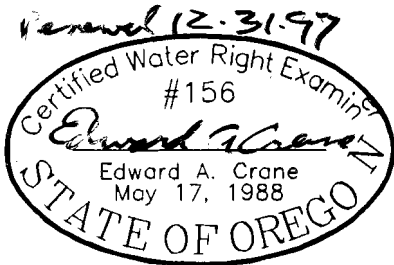

**FINAL PROOF SURVEY
 RESERVOIR PERMIT R-11537**

PREPARED BY EDWARD A. CRANE, CWRE

SURVEYED SEPT. 23, 1996
 BY EDWARD A. CRANE, CWRE

PREPARATION OF THIS MAP WAS FOR THE PURPOSE
 OF IDENTIFYING THE LOCATION OF THE WATER RIGHTS
 ONLY AND HAS NO INTENT TO PROVIDE DIMENSIONS
 OR LOCATION OF PROPERTY OWNERSHIP LINES.

I:\CAD\226-00\1\22600102.DWG 9/30/96 EAC

DATE
 SEPT 1996

PROJECT NO.
 226 002



CRANE & MERSETTI
 Engineering/Surveying

SUITE "D"
 6566 SE LAKE ROAD
 MILWAUKIE, OREGON 97222

BUS: (503) 654-2005
 FAX: (503) 654-2575

APPLICATION FOR PERMIT NUMBER R-73504
 PERMIT NUMBER R-11537 IN THE NAME OF:


SAM & JAN BARKLEY, dba
 BARKLEY FLORAL & NURSERY
 10486 SE TELFORD RD., BORING, OR 97009

FIGURE
 1/2

SE 1/4 OF THE SW 1/4 OF SECTION 25
 SW 1/4 OF THE SE 1/4 OF SECTION 25
 T1S & R3E WM, CLACKAMAS CO. OREGON


RES.#1 DAM IS 592' NORTH & 215' EAST AND
 RES.#2 DAM IS 250' NORTH & 85' EAST OF THE S 1/4
 COR. OF SEC. 25, T1S, R3E OF WM, CLACKAMAS CO. OR.

PREPARATION OF THIS MAP WAS FOR THE PURPOSE
 OF IDENTIFYING THE LOCATION OF THE WATER RIGHTS
 ONLY AND HAS NO INTENT TO PROVIDE DIMENSIONS
 OR LOCATION OF PROPERTY OWNERSHIP LINES.

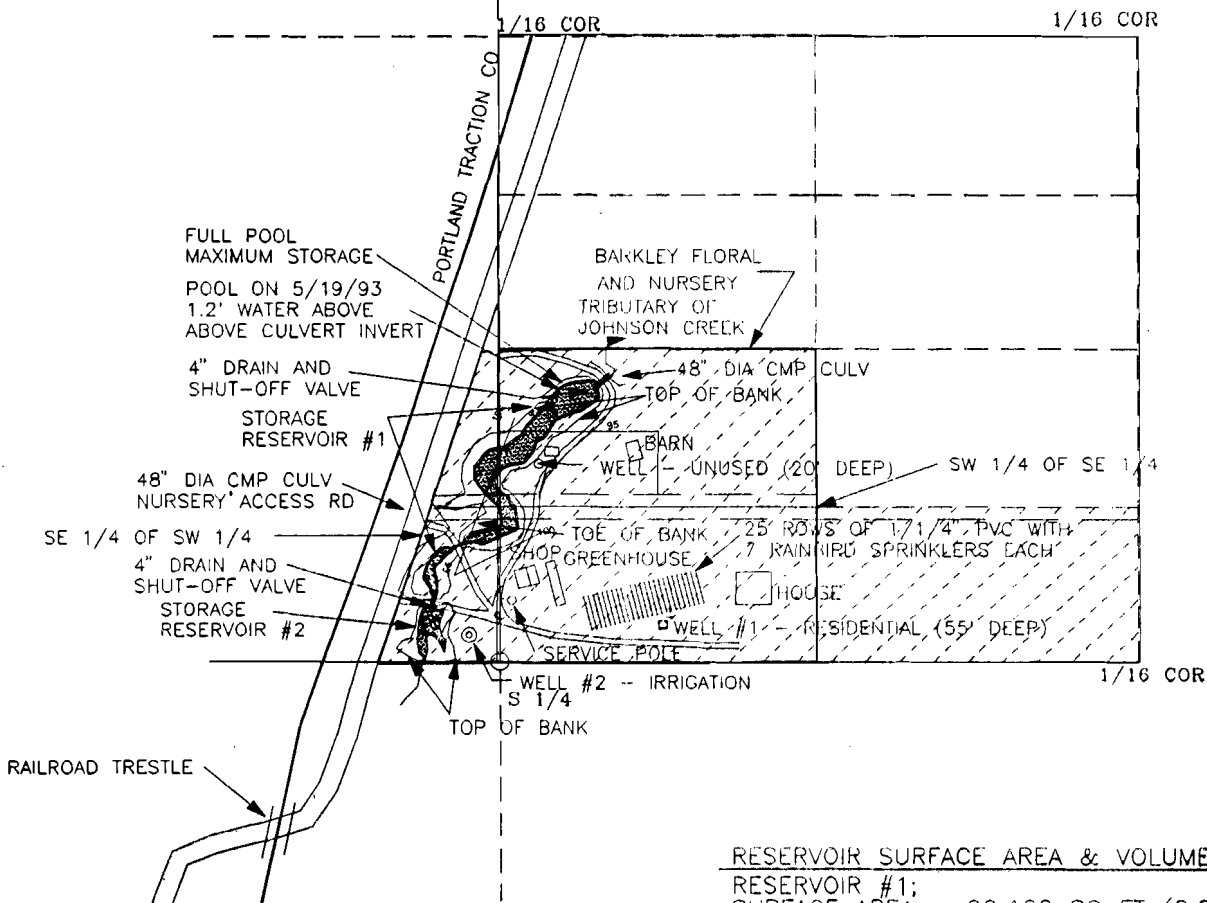

RESERVOIR SURFACE AREA & VOLUME

RESERVOIR #1;
 SURFACE AREA = 99,100 SQ FT (2.275 AC)
 MAXIMUM VOLUME = 376,795 CF (8.650 AC FT)
 RESERVOIR #2:
 SURFACE AREA = 15,550 SQ FT (0.357 AC)
 MAXIMUM VOLUME = 141,375 CF (3.25 AC FT)

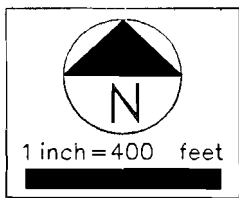

SURVEYED SEPT. 23, 1996
 BY EDWARD A. CRANE, CWRE

Renewed
 12-31-97

**FINAL PROOF SURVEY
 RESERVOIR PERMIT R-11537**

PREPARED BY EDWARD A. CRANE, CWRE


DATE SEPT. 1996		CRANE & MERSETH <i>Engineering/Surveying</i> SUITE "D" 6566 SE LAKE ROAD MILWAUKIE OREGON 97222 BUS: (503) 654-2005 FAX: (503) 654-2575	APPLICATION FOR PERMIT NUMBER <u>R-73504</u> PERMIT NUMBER <u>R-11537</u> IN THE NAME OF: SAM & JAN BARKLEY, dba BARKLEY FLORAL & NURSERY 486 SE TELFORD RD., BORING, OR 97009	FIGURE 2/2
--------------------	--	--	--	-------------------