

RECEIVED

SEP 09 2021

OWRD

RECEIVED

MAY 13 1999



WATER RESOURCES DEPT.
SALEM, OREGON

APPLICATION MAP

IN THE NAME OF SCOTT H. MC KENZIE

SECTIONS 29 & 32, T 31 S, R 15 W, W.M.

Brian and Kyle Arriola are assigning their portion of Permit R-12096 (as amended by T-8138), which is highlighted below, to Arriola Bogs, LLC

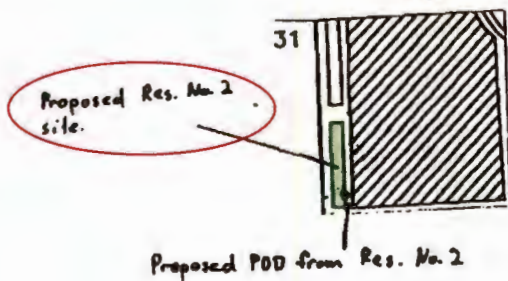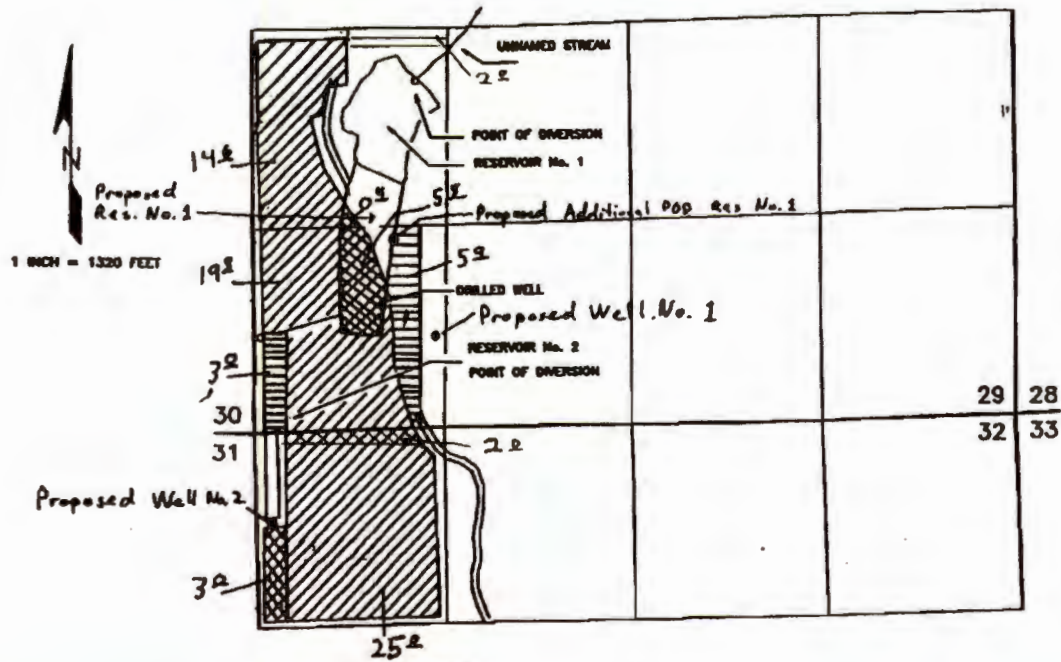

"From" POU



Proposed POU
"To"

