


# T.6S. R.1E. Section 19 T.6S. R.1W. Section 24, W.M.

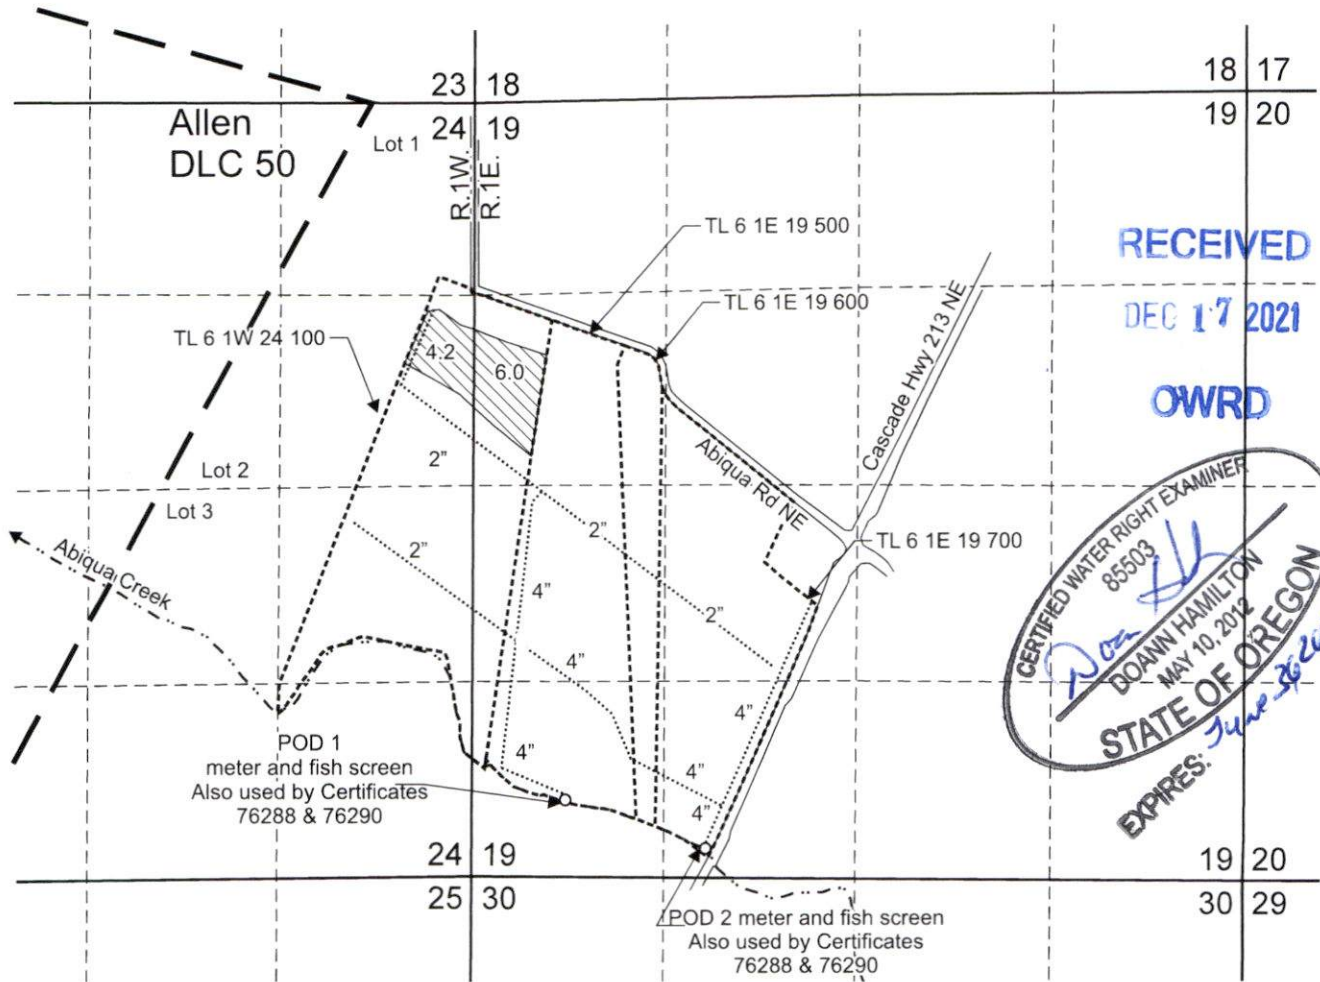


POD 1 (Certificate 76290 & 76288) is located 4,790 feet south and 720 feet east from the NW corner, Section 19.

POD 2 (Certificate 76290 & 76288) is located 5,090 feet south and 1,580 feet east from the NW corner, Section 19.

Area (10.2 Acres) irrigated under Application S-71040, Permit S-54015

— Donation Land Claim boundary      - - - - - Tax lot boundary      ..... Water main line

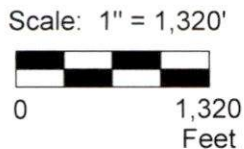

This map was prepared for the purpose of identifying the location of a water right only and is not intended to provide legal dimensions or location of property ownership lines.




Pacific Hydro-Geology Inc.

11/2021

**Claim of Beneficial Use Map**  
**Application S-71040, Permit S-55164**  
 Goschie Farms  
 T.6S. R.1E. Section 19,  
 T.6S. R.1W. Section 24, W.M.

Not. 344 Cl. 54  
As. 639.05

Samuel Allen  
Not. 403 Cl. 50  
As. 642.47

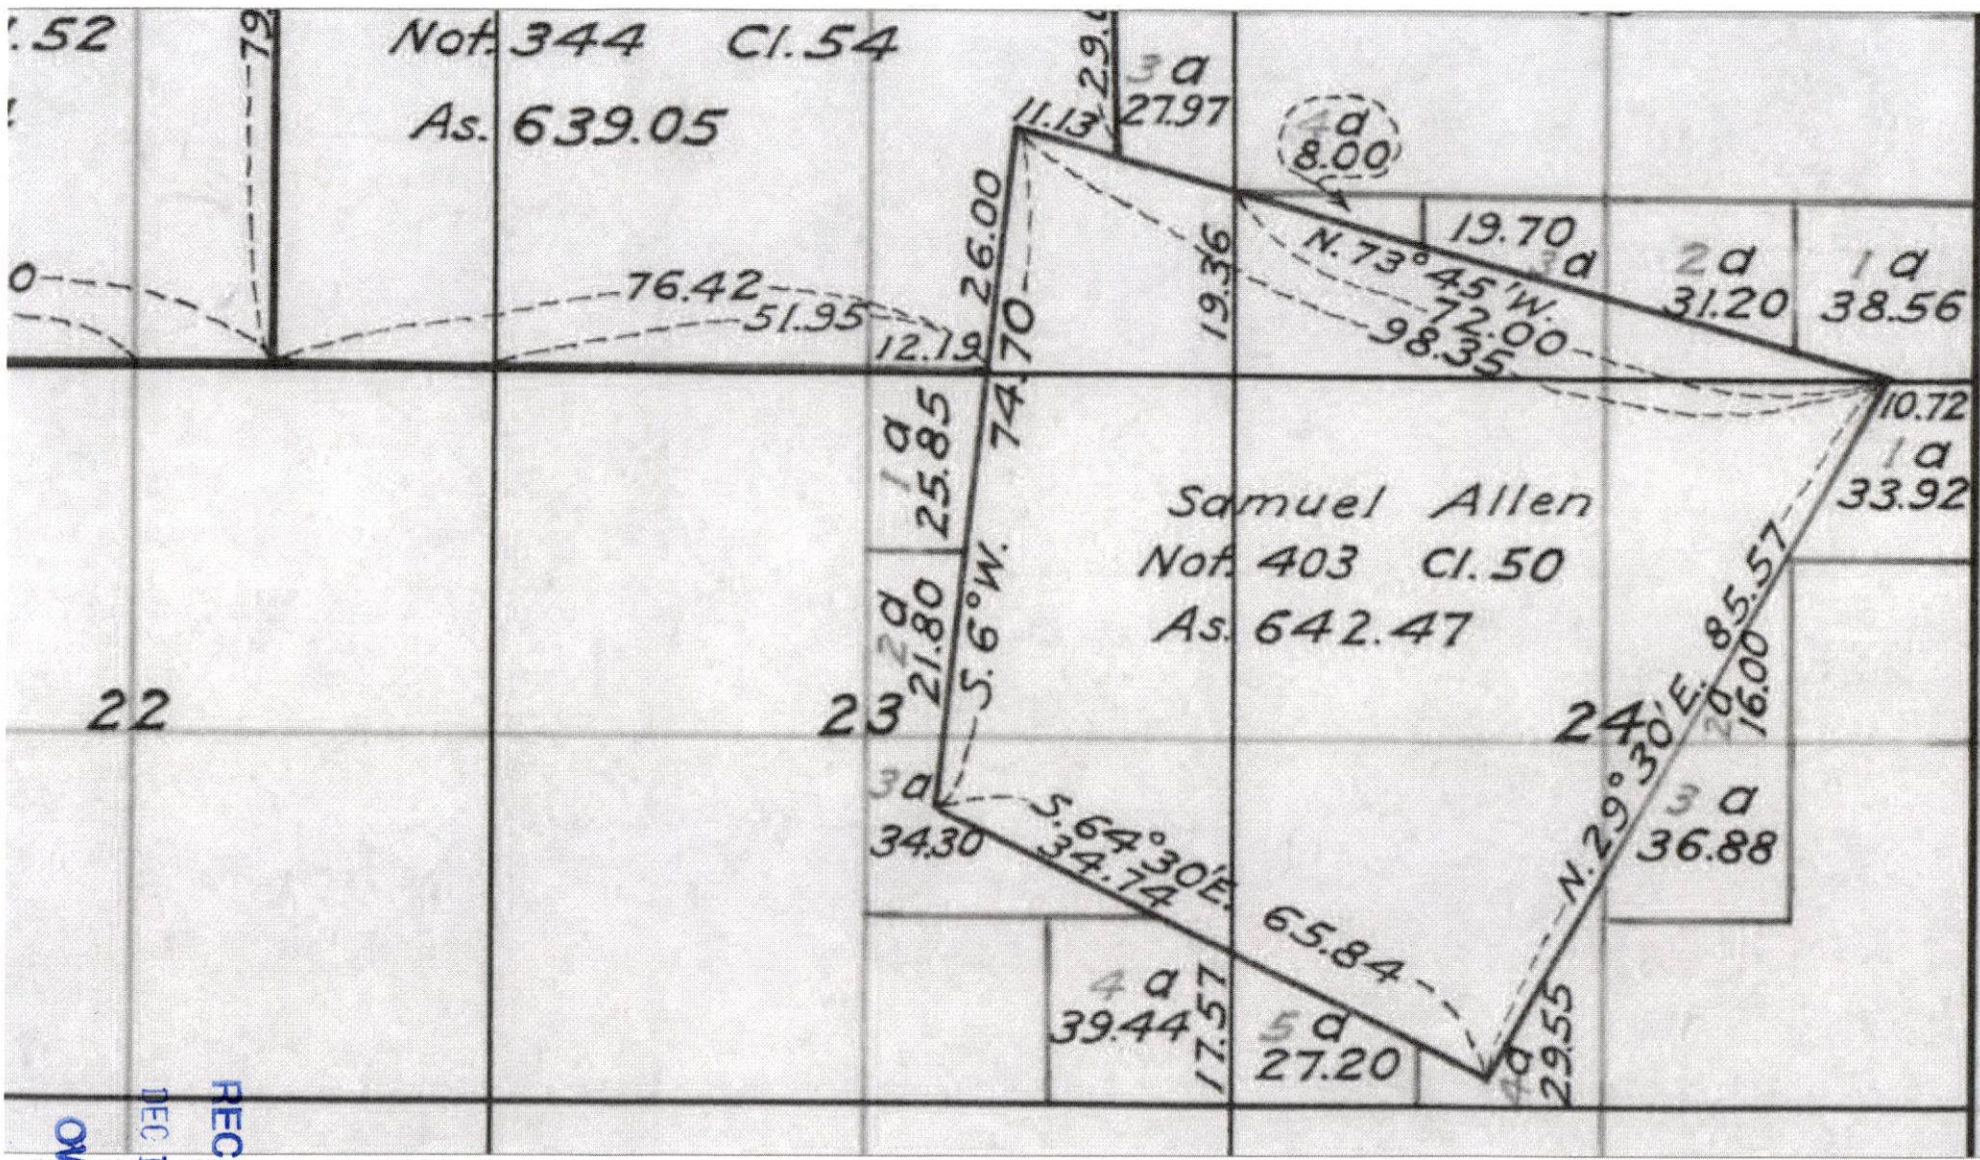


RECEIVED

DEC 17 2021

OWRD

# T.6S. R.1E. Section 19 T.6S. R.1W. Section 24, W.M.

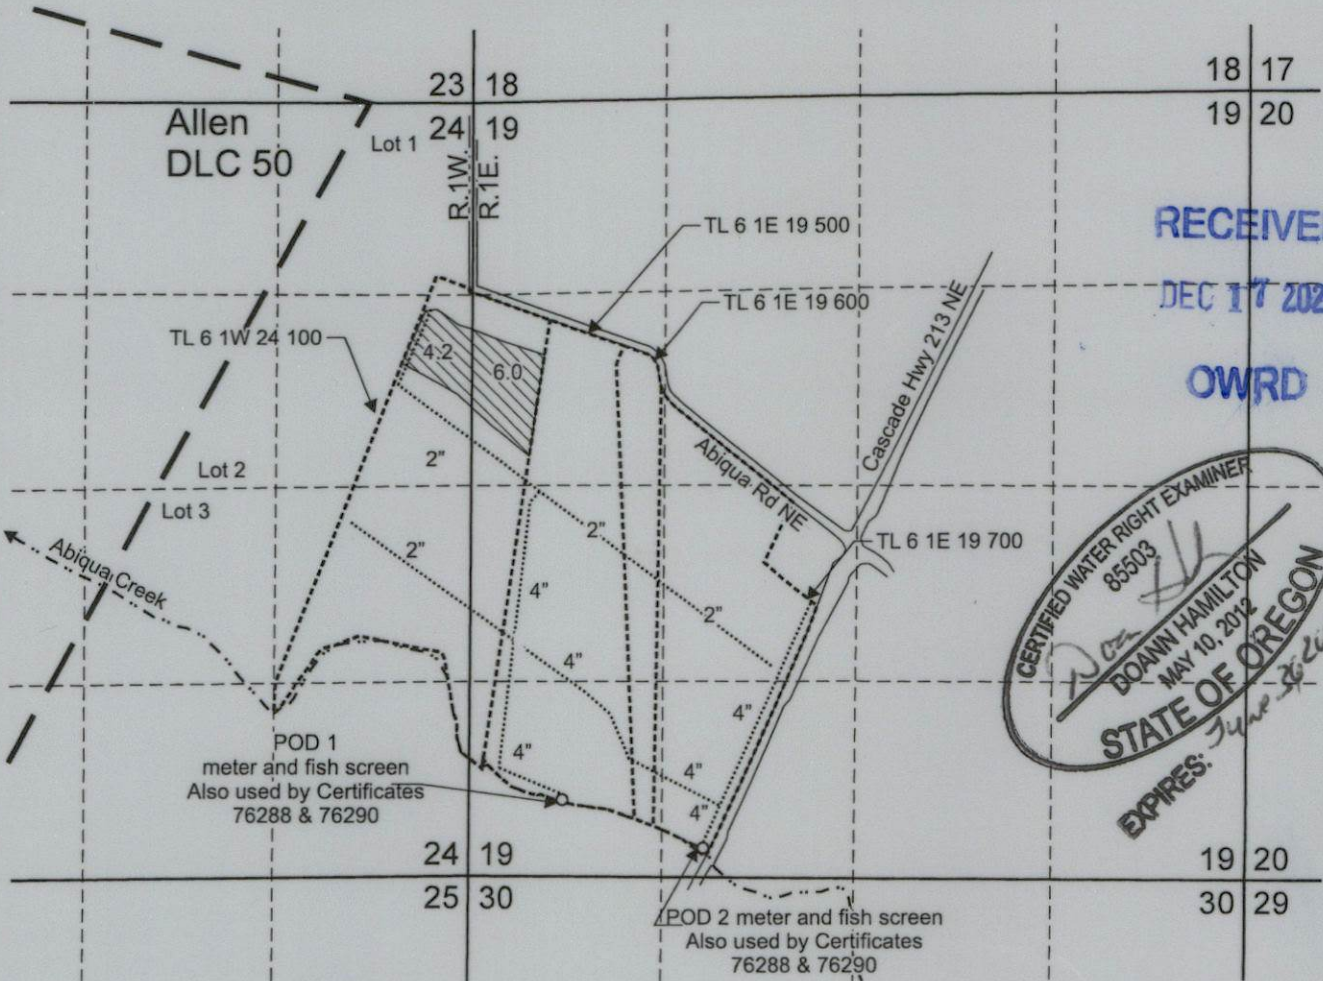


POD 1 (Certificate 76290 & 76288) is located 4,790 feet south and 720 feet east from the NW corner, Section 19.


POD 2 (Certificate 76290 & 76288) is located 5,090 feet south and 1,580 feet east from the NW corner, Section 19.

Area (10.2 Acres) irrigated under Application S-71040, Permit S-54015

Donation Land Claim boundary     
  Tax lot boundary     
  Water main line

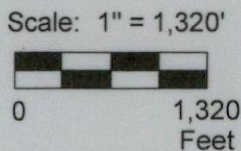

This map was prepared for the purpose of identifying the location of a water right only and is not intended to provide legal dimensions or location of property ownership lines.

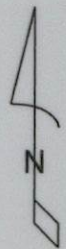

**Claim of Beneficial Use Map**  
**Application S-71040, Permit S-55164**  
 Goschie Farms  
 T.6S. R.1E. Section 19,  
 T.6S. R.1W. Section 24, W.M.

Pacific Hydro-Geology Inc.

11/2021