


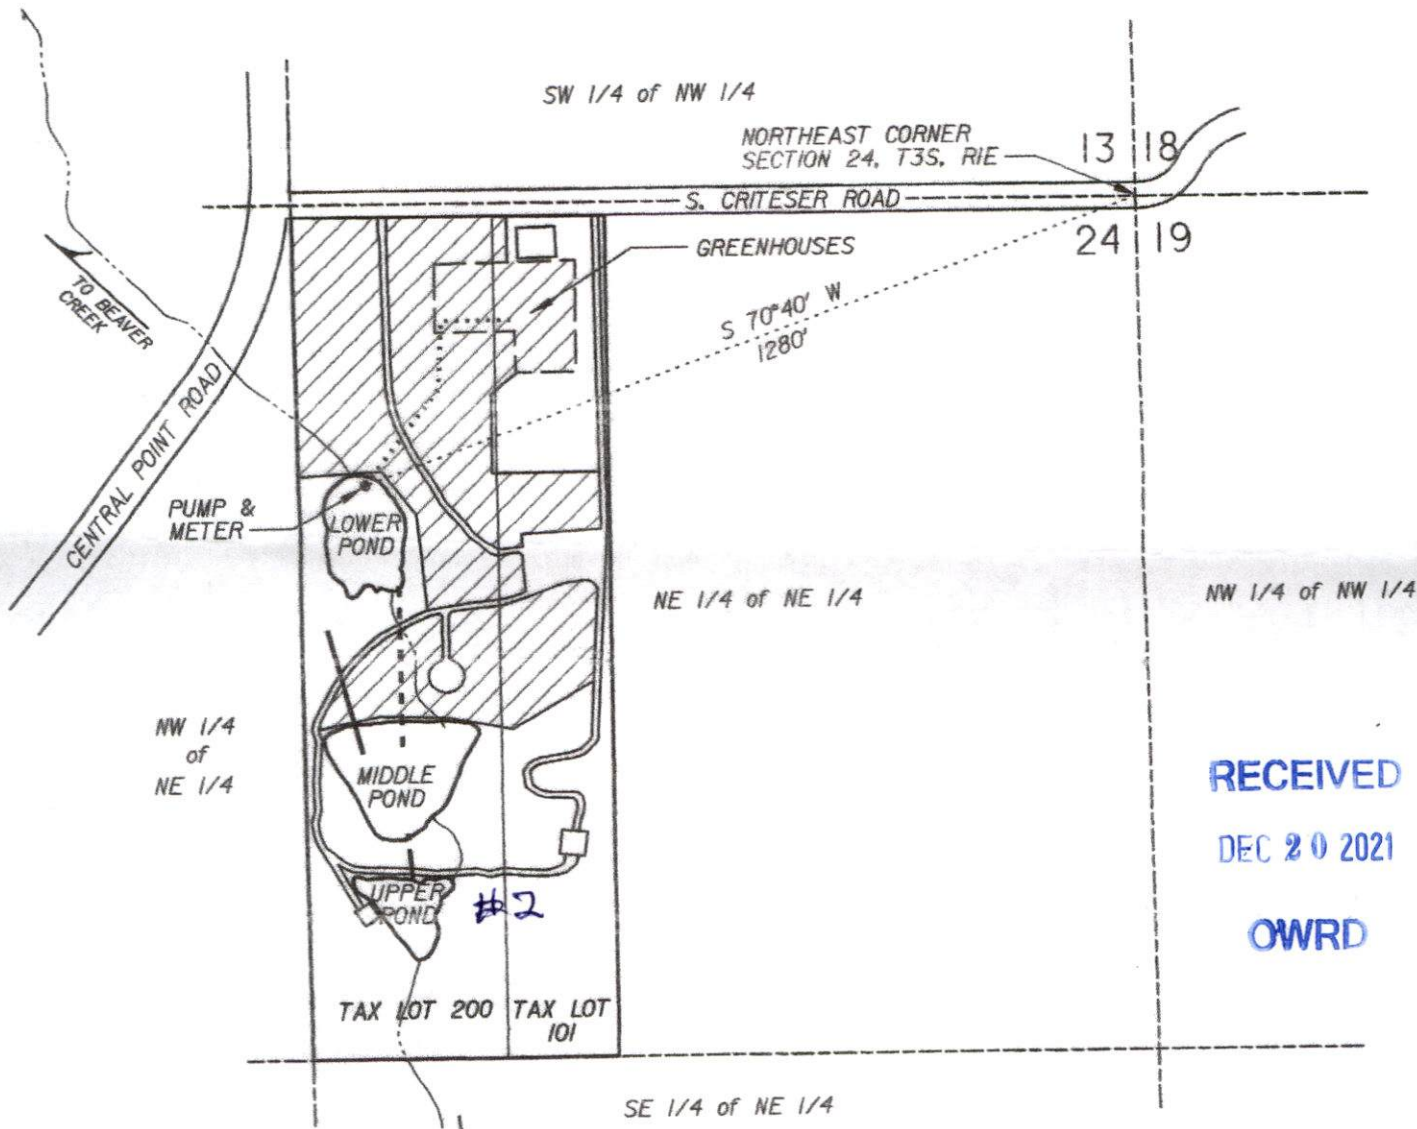

RECEIVED
DEC 20 2021
OWRD

LEGEND:

- IRRIGATED LAND
- BURIED 10" ADS OVERFLOW
- BURIED 8" PVC MAINLINE
- BURIED 6" ADS MAINLINE
- BURIED 2" PVC MAINLINE
- STRUCTURES

NOTES:
THIS DRAWING IS A PROOF SURVEY FOR A CLAIM OF BENEFICIAL USE TO PERFECT A SURFACE WATER RIGHT. IT IS NOT A LAND SURVEY. PROPERTY LINES AND/OR OTHER LINES OF OCCUPATION SHOWN HEREON ARE NOT REPRESENTED BY THE UNDERSIGNED TO MEET ACCURACY STANDARDS OF LAND SURVEYS.


SCALE: 1" = 300'

NE 1/4, NE 1/4
SECTION 24, T.3S., R.1E., W.M.
CLACKAMAS COUNTY, OREGON

5.4 TOTAL ACRES OF PASTURE,
NURSERY STOCK, GREENHOUSES
& GRAPES UNDER IRRIGATION

APPLICATION No. S-86575
PERMIT No. S-14348

BURL MOSTUL
SURFACE WATER PROOF SURVEY

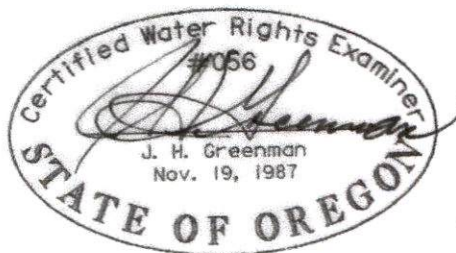

2018/05/14

H

R

S

**HANER, ROSS &
SPORSEEN, P.C.**
2895 Beaver Creek Road,
Oregon City, OR 97045