

RECEIVED

NOV 15 2021

OWRD

T 41S R11E  
SEC. 02

Tax lot

100	- 60 ACRE
200	93.91 "
600	27.7
700	8.96
800	33.03

Total 224.2

Scale

1" = 880'


SECTION 02 T.41S. R.11E. W.M.  
KLAMATH COUNTY

1"=400'

41 11 02

Map 1 of 1  
11/09/2021

THIS MAP WAS PREPARED FOR  
ASSESSMENT PURPOSE ONLY.

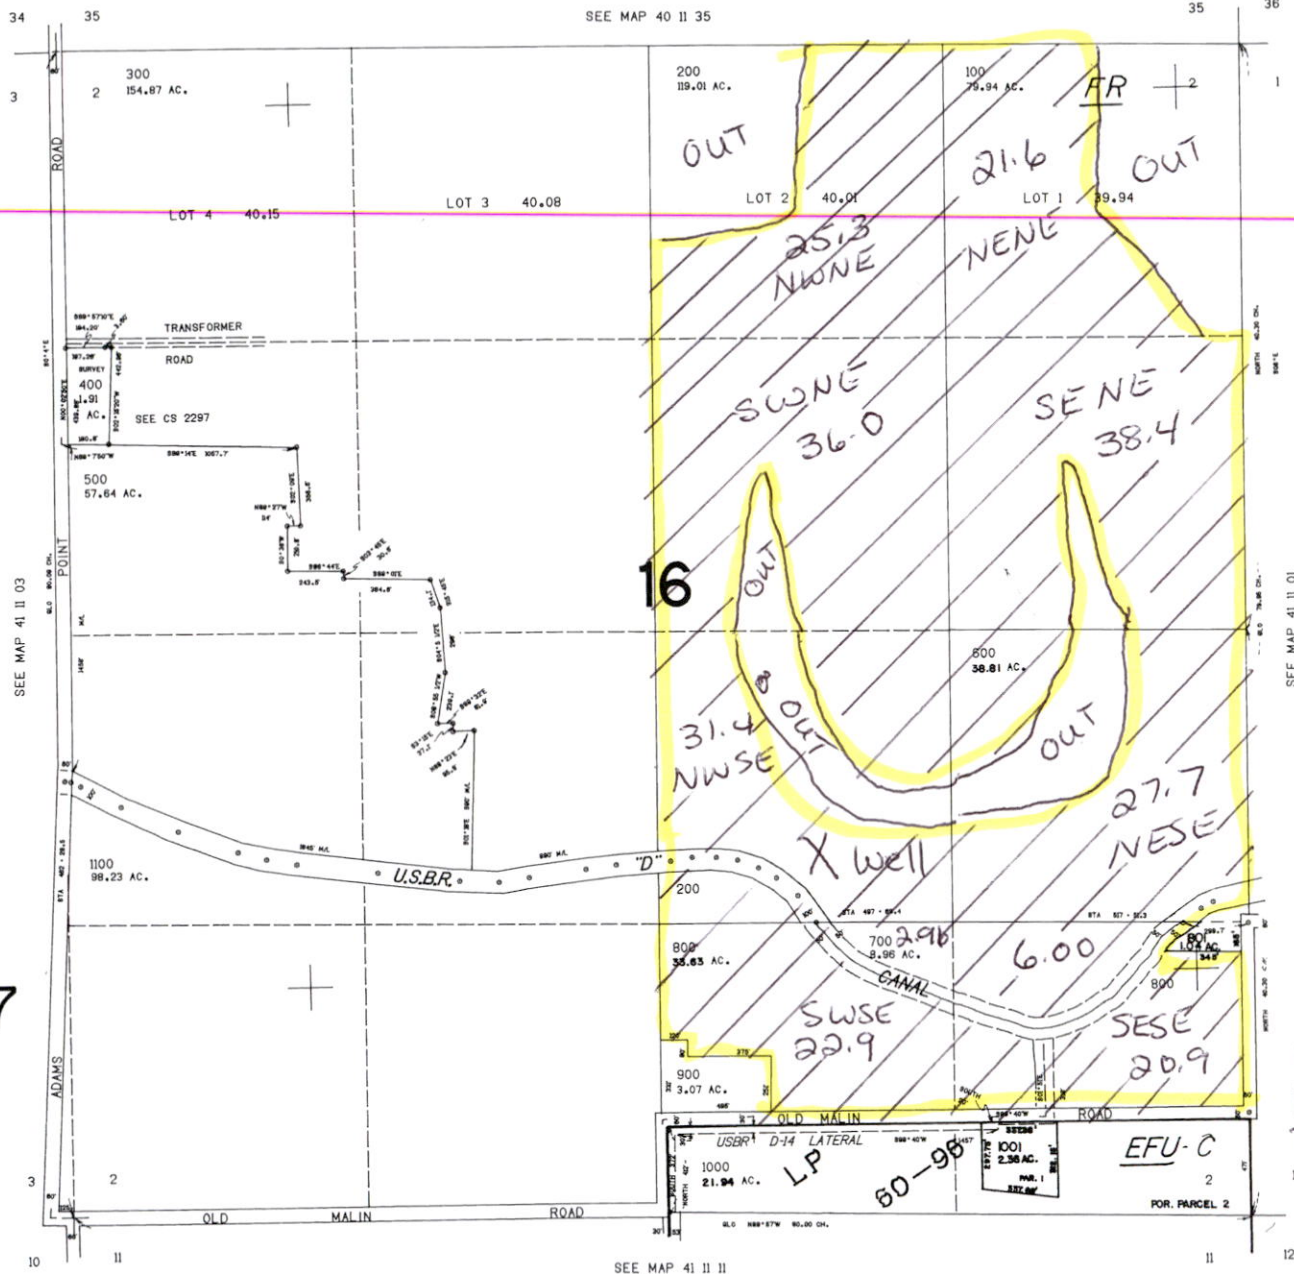

CANCELLED NOS  
601

133.000  
Well location  
1500 ft North  
1800ft West  
From SE  
CORNER Sec 2

17

SEE MAP 41 11 11

41 11 02

1.729.000