




WATER RIGHT APPLICATION MAP


SEIJI ESTATES
21485 SW CHAPMAN ROAD
SHERWOOD, OR 97140

SECTION 35, TOWNSHIP 2 N RANGE 2 W, W.M.
WASHINGTON COUNTY OREGON

LEGEND

- POINT OF APPROPRIATION (C-28615)
WELL 1 (WASH-13286)
750' E AND 220' N OF SW CORNER OF S 27
- POINT OF APPROPRIATION
WELL 2 (WASH-78965)
870' E AND 300' N OF SW CORNER OF S 27
- POINT OF APPROPRIATION
WELL 3 (WASH-77267)
650' E AND 1270' N OF SW CORNER OF S 27

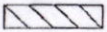 C-28615 ACREAGE – 2 ACS
SW SW – 2 ACS

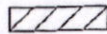
 PROPOSED ACREAGE – 20 ACS
SW SW – 20 ACS

*This map is not intended to provide legal
dimensions or locations of property
ownership lines*

ParsonsWater Consulting LLC
rick.parsons@parsonwater.com
541.499.0257 303.667.5067



UNNAMED TRIBUTARY TO CHICKEN CREEK

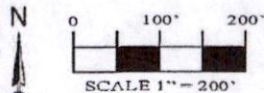

WELL 3

SW SW
SECTION 35

TL 300

TL 100

WELL 2

WELL 1

TL 200

SW CHAPMAN ROAD


RECEIVED

NOV 23 2021

OWRD

REFERENCE CORNER
SOUTHWEST CORNER SECTION 35

T.2 S. R.2 W.W.M.

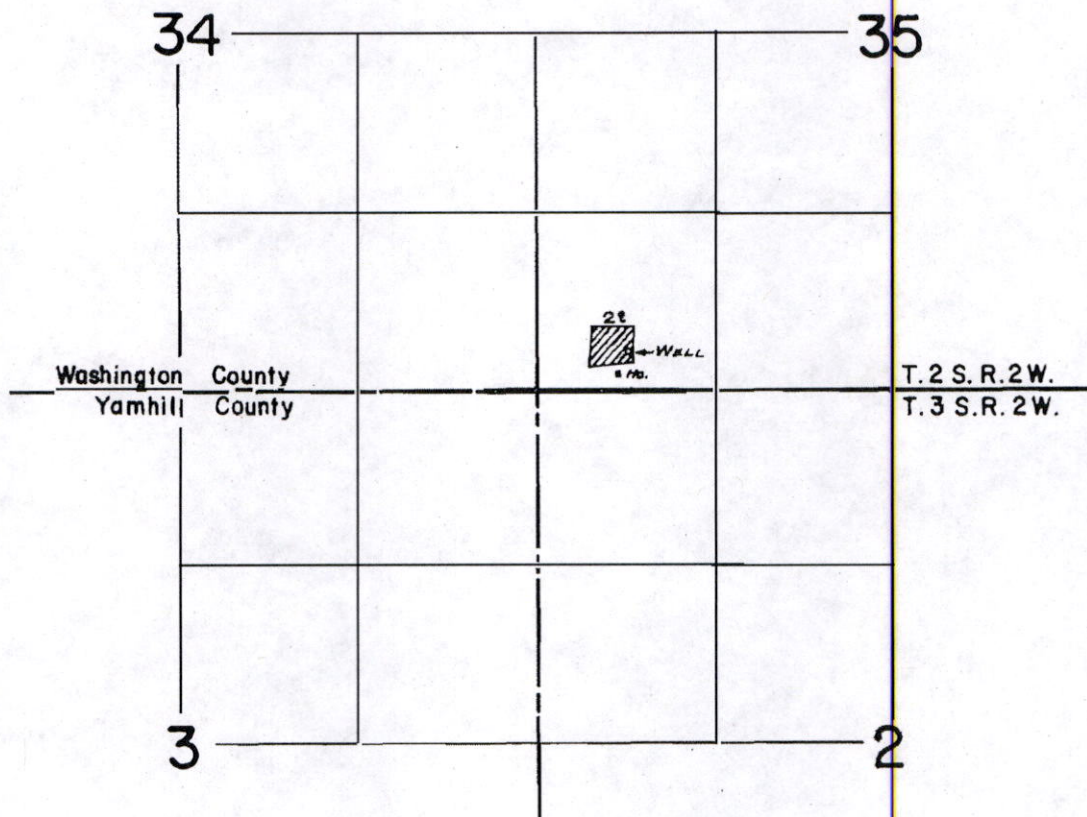

FINAL PROOF SURVEY
UNDER

RECEIVED

NOV 23 2021

OWRD

Application No. G-653 Permit No. G-566
IN NAME OF

RICHARD B. JOYCE

Surveyed June 24 1960, by

[Signature]

1960-K