

**CLAIM OF
BENEFICIAL USE
for Reservoirs storing less than
9.2 acre-feet permitted under
ORS 537.409**



Oregon Water Resources Department
725 Summer Street NE, Suite A
Salem, Oregon 97301-1266
(503) 986-0900
www.oregon.gov/OWRD

RECEIVED

DEC 27 2021

OWRD

**A fee of \$230 must accompany this form.
The Claim will be returned if the fee is not included.**

This form may be completed by the permit holder of record if:

- 1) The permit was issued under the authority of ORS 537.409; and**
- 2) No secondary permit exists for the use of water stored in the reservoir; and**
- 3) The developed capacity of the reservoir is less than 9.2 acre-feet; and**
- 4) The water was stored by the date required in the permit; and**

A separate form shall be completed for each permit.

This form must be submitted to the Water Resources Department within one year of storage of water in the reservoir.

Please type or print in dark ink. If the data provided is found to contain errors or omissions, it may be returned. The Department may require the submittal of additional information.

If you have questions regarding the completion of this form, please call 503-979-9103.

**SECTION 1
GENERAL INFORMATION**

File Information:

APPLICATION # R-88846	PERMIT # R-15455
--	-----------------------------------

POND 1

Applicant Information:

APPLICANT NAME Bente Kongsore		PHONE NO. (541) 895-3010	ADDITIONAL CONTACT NO. (541) 735-1358
ADDRESS PO Box 459			
CITY Creswell	STATE OR	ZIP 97426	E-MAIL bentkongsore@gmail.com

SECTION 2
RESERVOIR INFORMATION

RECEIVED

DEC 27 2021

OWRD

Reservoir Dimensions and Capacity:

AVERAGE LENGTH	Surface Area	AVERAGE WIDTH	AVERAGE DEPTH	MAXIMUM CAPACITY IN ACRE-FEET
*	0.33 acres		2.6'	0.86 AF

To determine capacity in acre-feet use for the above table, use the following calculation:

$$\text{Acre-feet} = \frac{(\text{Average Length})(\text{Average Width})(\text{Average Depth})}{43,560}$$

* Due to the irregular shape of the pond, a GPS rover was used to calculate the surface area and volume. Average depth was calculated from these values.

SECTION 3

MAP

Attach a map identifying the reservoir location. If the water right application map accurately reflects the location of the reservoir, you may attach a copy of it. Otherwise, you must submit a map meeting the standards of OAR 690-310-0050, which are attached.


Preparation of the map by a Certified Water Rights Examiner is **not** required for this type of permit, but may be submitted.

SECTION 4

SIGNATURE

This Claim of Beneficial Use must be signed by each permit holder of record.

By my signature, I certify that the information contained herein is true and correct to the best of my knowledge.

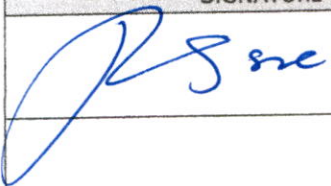SIGNATURE	PRINT OR TYPE NAME	TITLE	DATE
	Bente Kongsore	owner	12/22/21


RECEIVED

DEC 27 2021

OWRD

**Claim of Beneficial Use
Kongsore, Bente
Permits R-15455, R-15456, R-15457**

Township 19S, Range 4W, W.M.

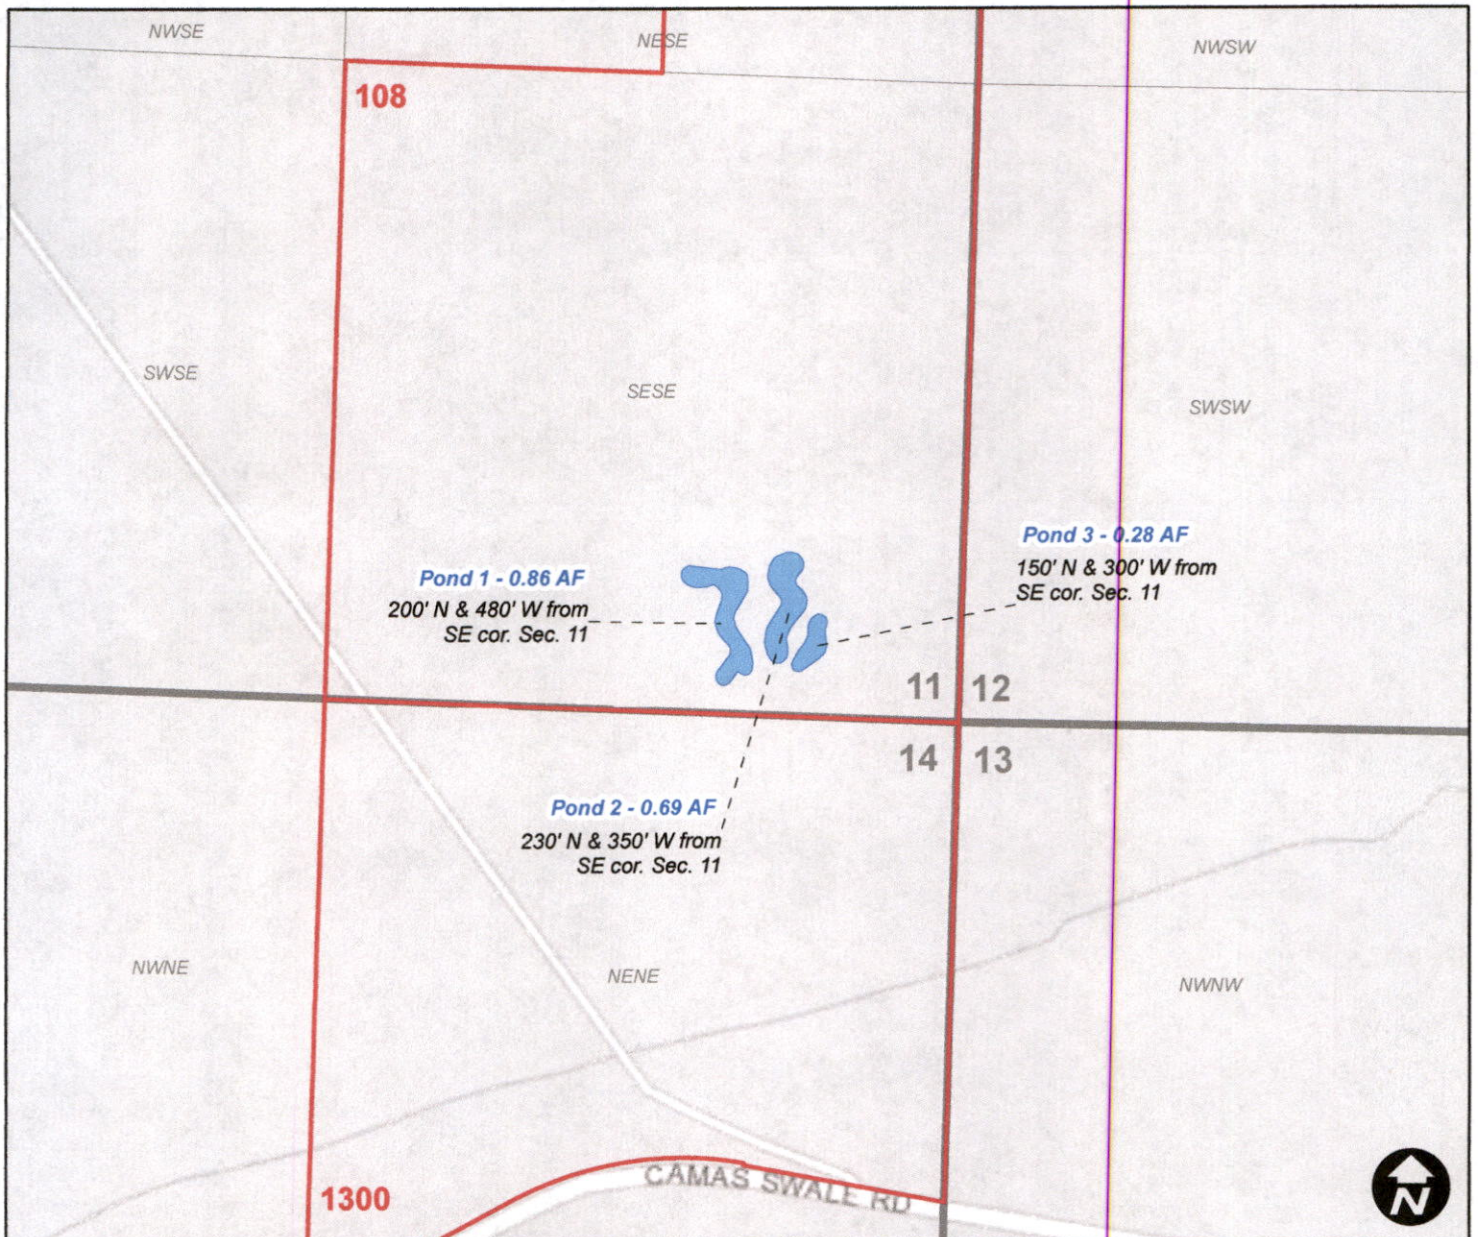

This map is not intended to provide legal dimensions or locations of property ownership lines.

0 200 400 800 Feet

Legend

-  POU (Reservoirs)
-  Tax Lot



Oregon

Kate Brown., Governor

Department of Fish and Wildlife

The Dalles Screen Shop

3561 Klindt Drive

The Dalles, OR 97058

(541) 296-8026

FAX (541) 296-7889

odfw.com

RECEIVED

DEC 27 2021

OWRD



September 28, 2021

Attn. Bente Kongsore
30709 Camas Swale Rd
Creswell, OR 97426

RE: Permit R-15455, R-15456, R-15457

To whom it may concern,

This letter is in regards to fish screening and passage requirements set forth in the Oregon Water Resources Department Permit R-15455, R-15456, and R-15457.

The Oregon Department of Fish and Wildlife's Upper Willamette Assistant District fish biologist, Mr. Jeremy Romer, has determined that these are off-channel reservoirs filled from runoff, and have no connectivity to stream or surface water. To clarify, no water should ever be pumped from any nearby stream to fill ponds, and no drainage pipe should be used to concentrate excess flow from the ponds. As long as these criteria are met fish screening and passage requirements are waived, and this letter serves as an exemption from these requirements at this location.

If you have any questions in regards to this letter, please contact me at 541-967-2162.

Sincerely,

Bryce Macnab

Fish Screen and Passage Coordinator

CC: Will McGill PLS - CWRE

Jeremy Romer - ODFW