


Claim of Beneficial Use - Oakwood Water Systems Inc. Application G-12256, Permit G-11218

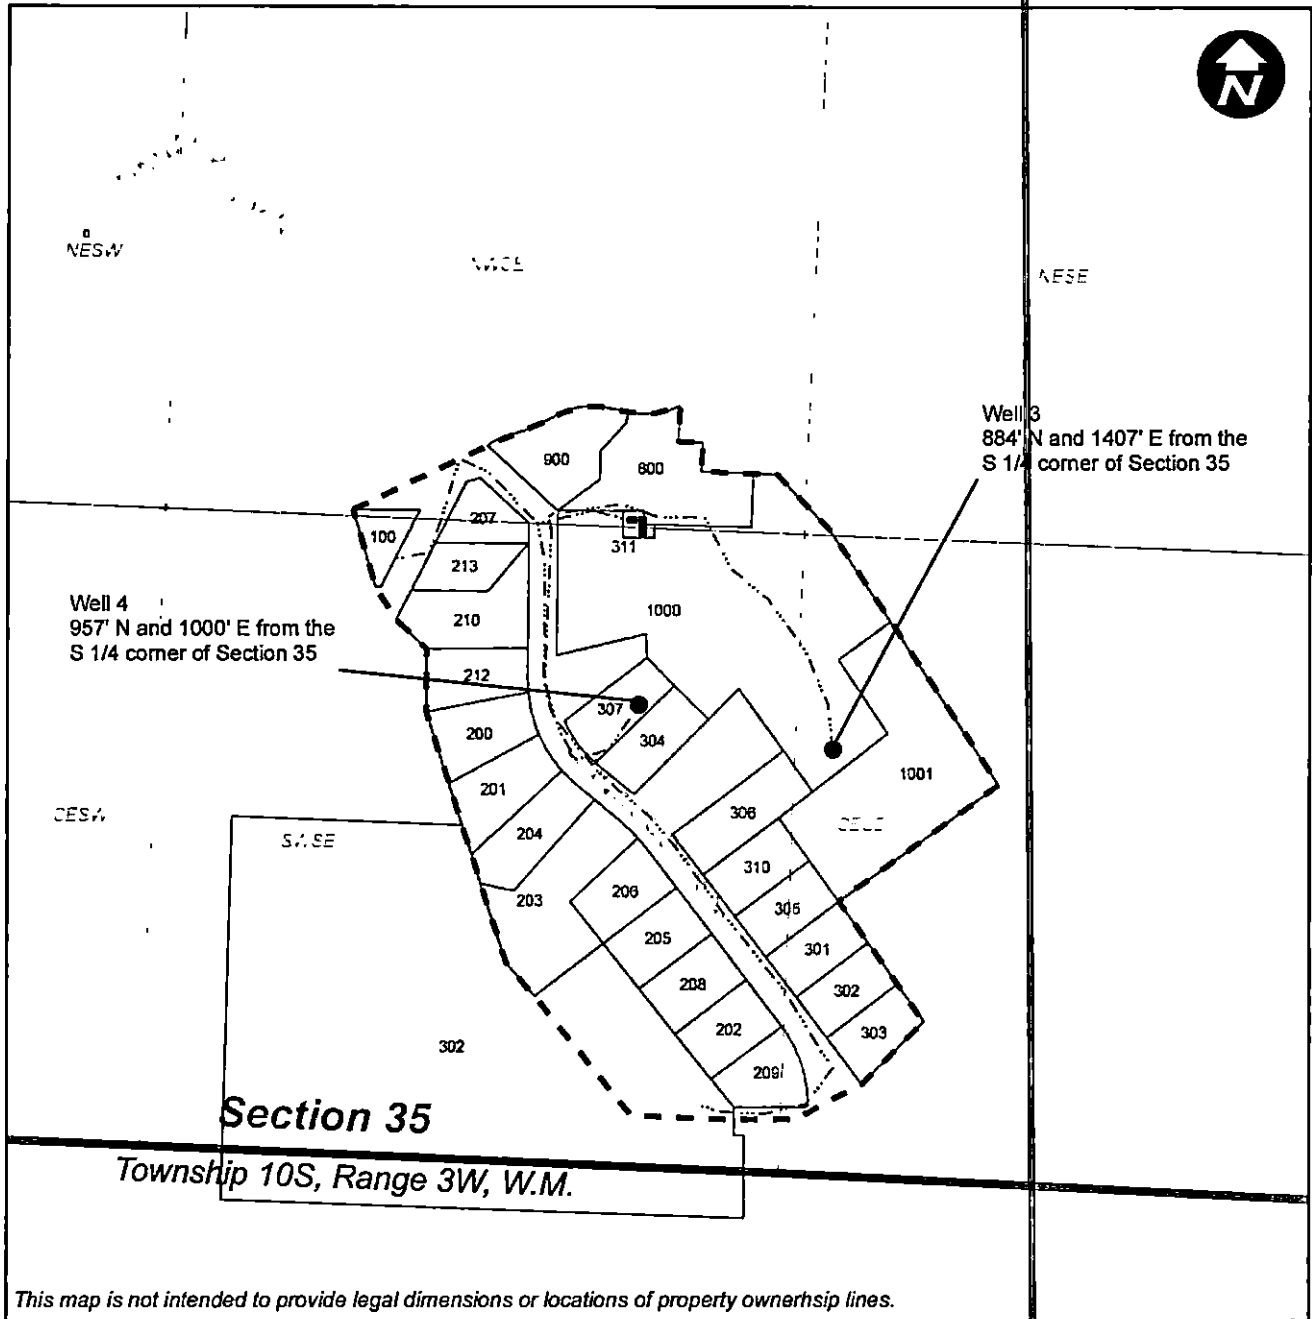

0 200 400 800 Feet

Legend

- Pipeline
- ▣ Service Boundary (POU)
- ▣ Pump House
- ▣ Tax Lots
- ▣ Storage Tank



EXPIRES: 12-31-2022