

OWRD

725 Summer St NE, Sale



POU

RECEIVED

DEC 23 2021

Oregon Water Resources Department
Water Rights Mapping Tool

725 Summer St NE, Sale

OWRD

Search

+

Ident
Non-
Water
Right
Featu

-

Tax
Lots

Laye

Tools



POD

POU

POD

-123

45.14

Oregon Water Resources Department
Water Rights Mapping Tool

DEC 23 2021

DEC 23 2021

OWRD

OWRD

Search

Identify Non-Water Right
Features

Tax Lots

Layers

Tools

Additional Measure Tools:

Buffer: Feet

Start Point: Clear All:

Measure Distance (ft):

150 ☐ N
300 ☐ S
☐ E ☐
☒ W

Bearing and Distance:

Degrees Minutes Seconds

☒ N
☐ S
(0-90) (0-60) (0-60)

Distance (ft):

☐

Messages:



POD

POU

-123.11 45.14

SE corner
Section 12

DEC 23 2021

x_____xOSAnK3_IT9yT2szKzgO7iA...x_____x_ags_3e5bd498-4955-11eb-a663-22000b8e8a59.jpg (1056x816)


OWRD

MAR 08 2021

RECEIVED

OWRD

Yamhill County Map

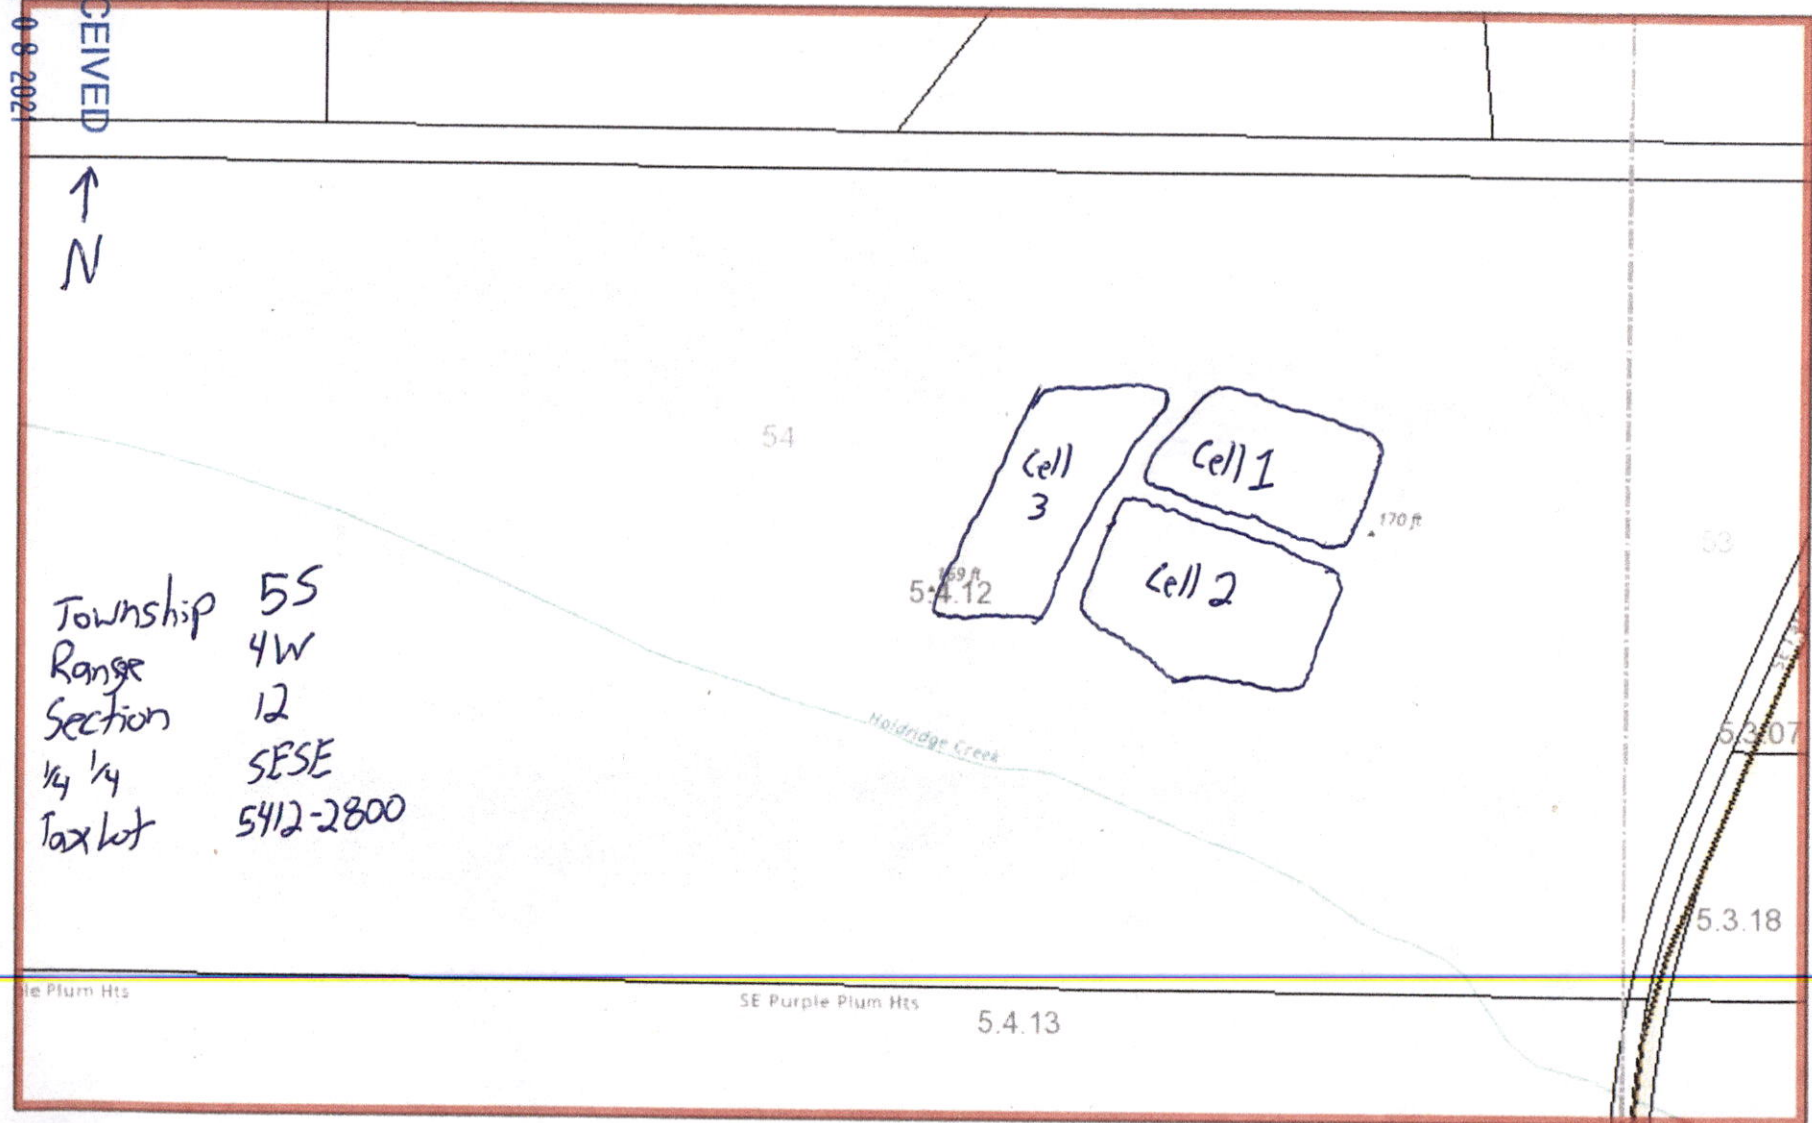

December 28, 2020

SL

 City Boundary

County Roads



☐ Taxlots



UGB_YamhillCo County

☐ County

☐ Townships

Tax Label

1:4,800



Sources: Ext. Airbus DS, USGS, VOA, NASA, CGAR, N. Robinson, NCEAS

Yamhill County G45
Yamhill County 2014