

OWRD

MAR 08 2021

RECEIVED

↑
N


Yamhill County Map

RECEIVED

DEC 23 2021

OWRD

Township 5S
Range 4W
Section 12
1/4 1/4 SESE
Tax lot 5412-2800

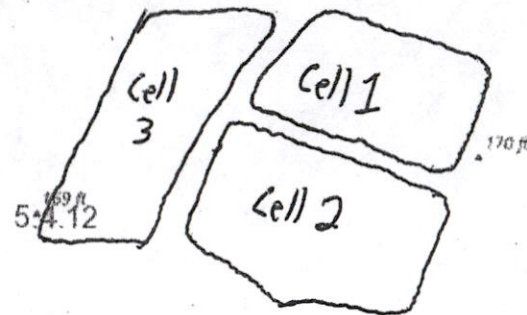

SE Plum Hts

SE Plum Hts

5.4.13

5.3.07

5.3.18

December 28, 2020

SL



City Boundary



County Roads



Taxlots



UGB_YamhillCo




County



Townships

Tax Label

1:4,800

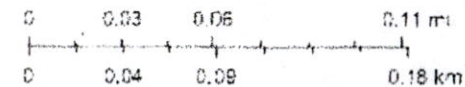

Source: Esri, DeLorme, USGS, NOAA, NGA, NAD, GDR, N, Rep, nra, NCEAS

Yamhill County GIS
Yamhill County GISSE corner
of Section
12

RECEIVED

DEC 23 2021

Oregon Water Resources Department
Water Rights Mapping Tool

725 Summer St NE, Sale

OWRD



POD

POU

-123.117 45.145

RECEIVED

DEC 23 2021

Oregon Water Resources Department
Water Rights Mapping Tool

725 Summer St NE, Sale

OWRD

Search

Ident
Non-
Water
Right
Feat

Tax
Lots

Laye

Tools



POD

POU

POD

-123.115

45.145

RECEIVED

DEC 23 2021

Oregon Water Resources Department
Water Rights Mapping Tool

725 Summer St NE, Sale

OWRD



POD

POU

RECEIVED

DEC 23 2021

Oregon Water Resources Department
Water Rights Mapping Tool



Search

Identify Non-Water Right
Features

Tax Lots

Layers

Tools

Additional Measure Tools:

Buffer: Feet

Start Point: Clear All:

Measure Distance (ft):

☒ N

☐ S

☐ E

☒ W

☐

Bearing and Distance:

Degrees Minutes Seconds

☒ N

☐ S

(0-90) (0-60) (0-60)

Distance (ft):

☐

Messages:



POD

POU

pod

-123.11

45.14