

RECEIVED

JAN 03 2022

OWRD

THIS MAP WAS PREPARED FOR ASSESSMENT PURPOSE ONLY.

SW1/4 SEC.14 T.26S. R.5W. W.M. DOUGLAS COUNTY 1" = 200'

REVISED 8-31-21


26 5 14C

1/4 CDR

SEE MAP 26 5 14A

N ↑

15 14
22 23

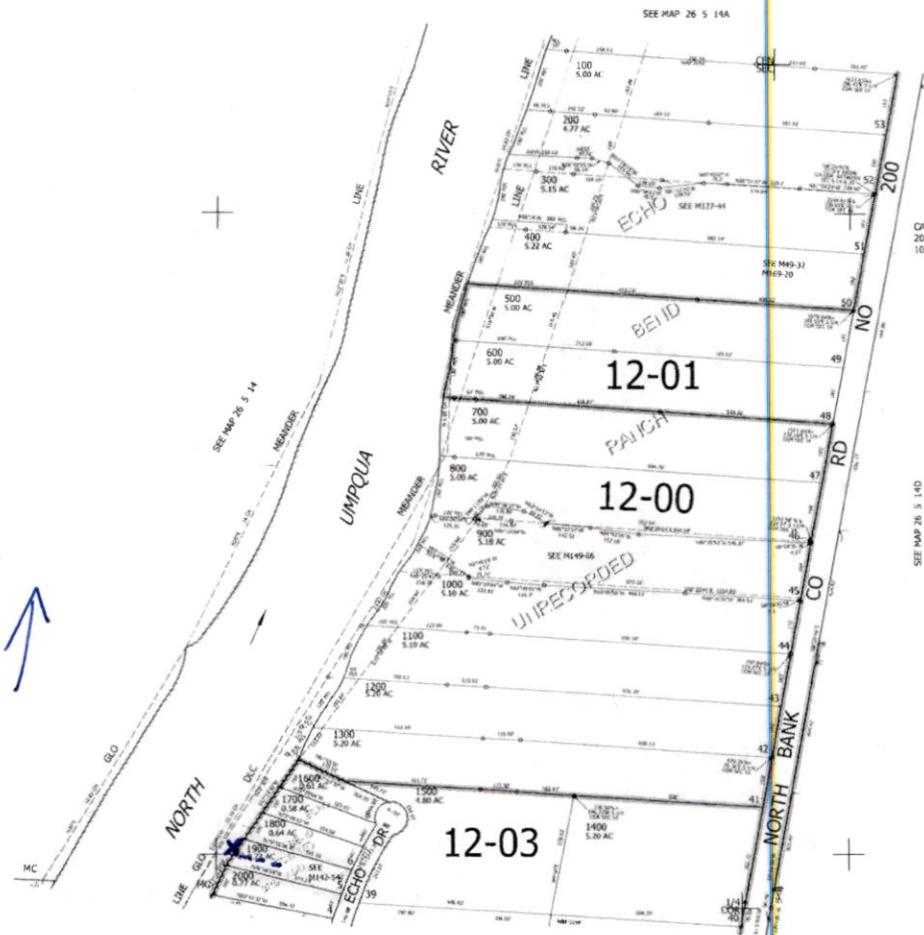

CANCELLED NOS
201 301 901
1001 902 801

SEE MAP 26 5 14D

608,000

SEE MAP 26 5 23

1,188,000

120' N 920' E from SW corner, SWSW 26 5-14C

x = pump

POU = TL 1900


1 inch to 400

PLOT PLAN	Worksheet #:	Property ID #:	R 69505
Applicant:	William R. & Elizabeth J. Ruegg	Phone #:	541.784.8595
Site Address:	0 Echo Drive	Co. Road #:	


INFORMATION NEEDED:

1. Proposed Structure and Distance from Property Lines
2. Other Existing Structures on Property
3. Access Road and Driveway Location
4. Landmarks (Roads, Rivers, etc.)
5. Indicate Direction of Drainage from Building Site
6. Indicate Location of Septic System and Water / Sewer Lines
7. Initial Waiver at Bottom of Page

EXAMPLE:

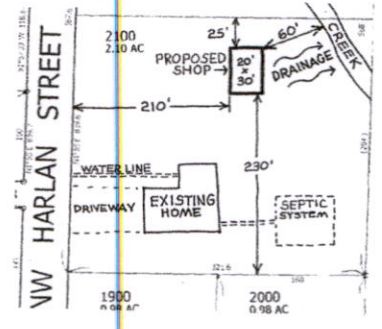

RECEIVED
 JAN 03 2022
 OWRD

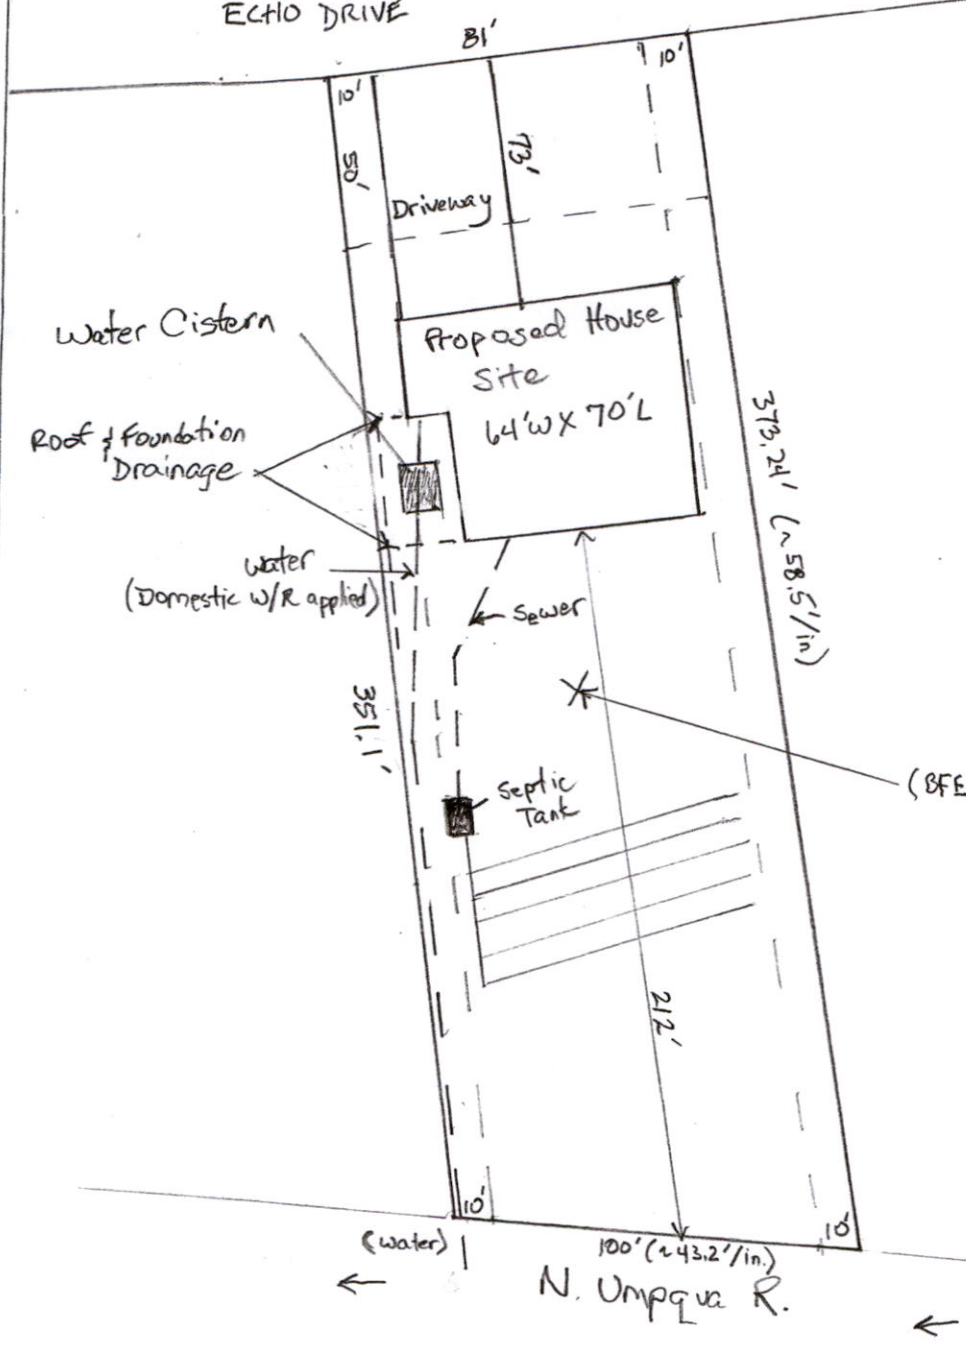

WAIVER: I understand it is the responsibility of the applicant and property owner to consider issues such as drainage, flooding, soil stability, or excessive slopes in this project. I also understand that approval of this Pre-Application Worksheet and Plot Plan does not release me from compliance with private covenants, restrictions, or easements affecting this property.

(Initials) W.R.R.