


**Township 1 South, Range 25 East, W.M.
Morrow County, Oregon
Section 36**

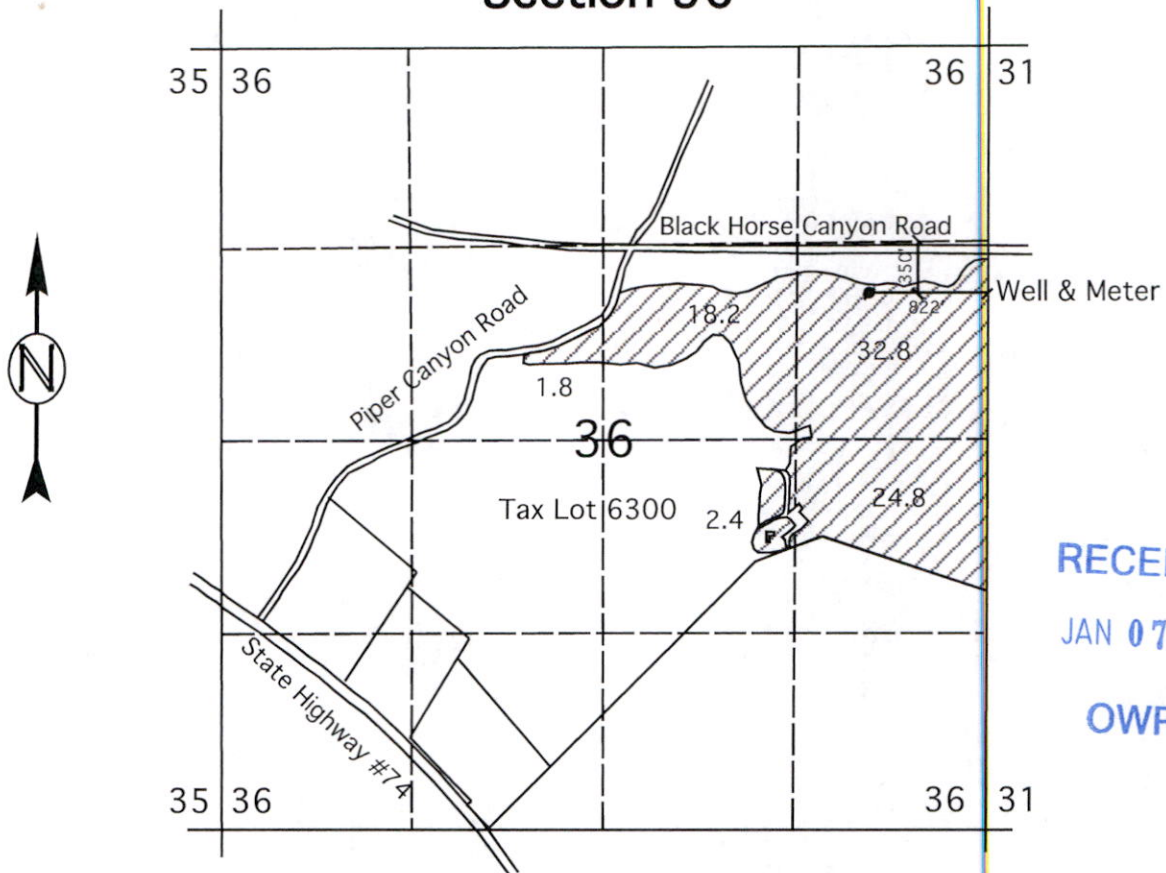

RECEIVED
JAN 07 2022
OWRD

Well Located 350' South & 822' West of N 1/16 Corner Section 36, SE 1/4 NE 1/4 , Section 36.
Lat. N 45° 26' 19.595", Lon. W 119° 38' 30.442"
Meter Found South 5' From Well in 4" Mainline.



Irrigation For Permit G-15011
Found At This Location


This Map is for the purpose
of identifying the location of
Water Rights only and is not
intended to provide the
legal dimensions or
locations of property
ownership lines.

FINAL PROOF MAP

In Name Of

Douglas & Tacey Johnson

SCALE 1" = 1320

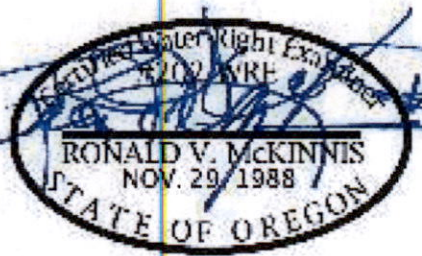

Expires 12-31-22

ENGINEERING - LAND SURVEYING - WATER RIGHTS

R. V. McKINNIS ENGINEERING



79980 Prindle Loop Road
Hermiston, Oregon 97838
(541) -567-2017




**Township 1 South, Range 25 East, W.M.
Morrow County, Oregon
Section 36**

RECEIVED

JAN 07 2022

OWRD

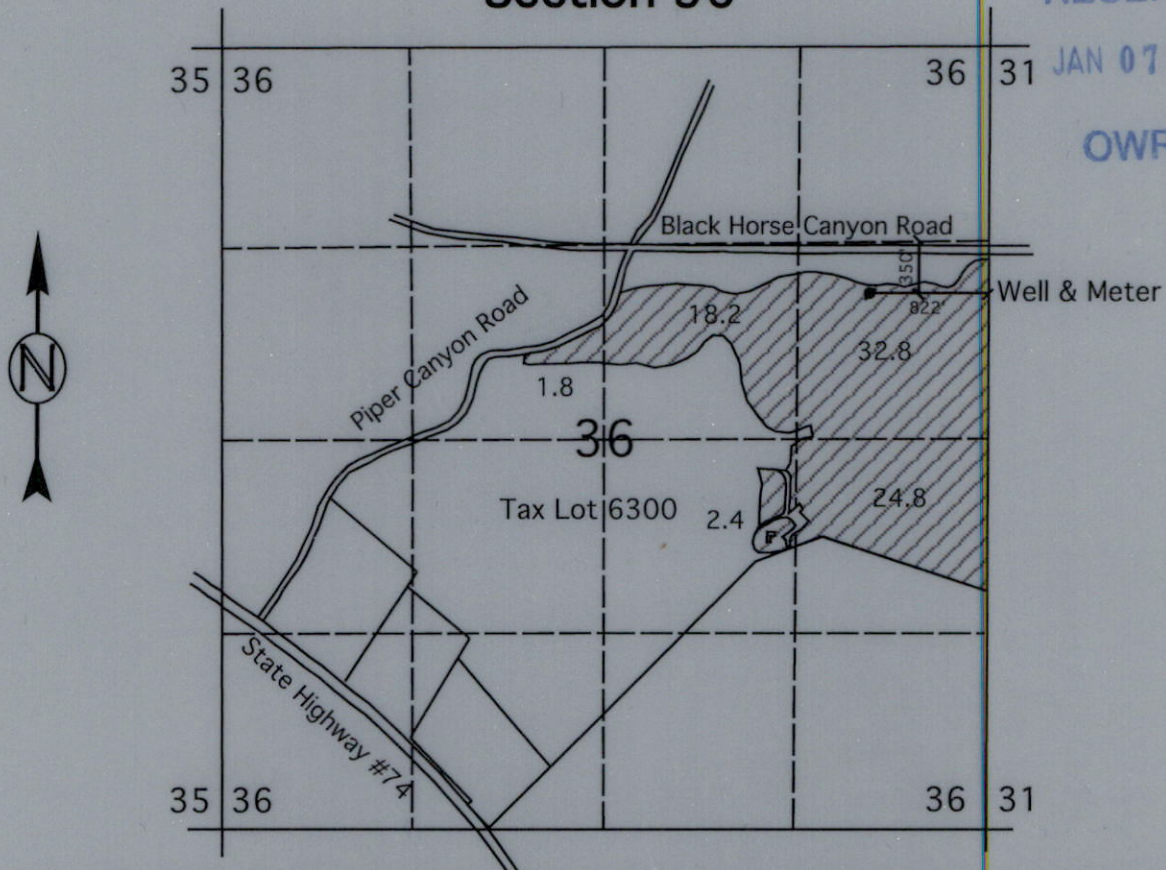

Well Located 350' South & 822' West of N 1/16 Corner Section 36, SE 1/4 NE 1/4 , Section 36.
Lat. N 45° 26' 19.595", Lon. W 119° 38' 30.442"
Meter Found South 5' From Well in 4" Mainline.



Irrigation For Permit G-15011
Found At This Location


This Map is for the purpose
of identifying the location of
Water Rights only and is not
intended to provide the
legal dimensions or
locations of property
ownership lines.

FINAL PROOF MAP

In Name Of

Douglas & Tacey Johnson

SCALE 1" = 1320

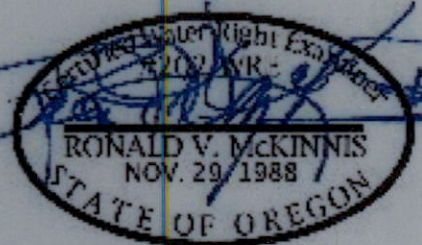

Expires 12-31-22

ENGINEERING - LAND SURVEYING - WATER RIGHTS

R. V. McKINNIS ENGINEERING



79980 Prindle Loop Road
Hermiston, Oregon 97838
(541) -567-2017

