

CLAIM OF BENEFICIAL USE

FOR
KETCHAM LIVING TRUST
 TRANSFER NO. T-7984



NOTE:
 PREPARATION OF THIS MAP IS FOR IDENTIFYING PROPOSED
 WATER RIGHTS ONLY. IT HAS NO INTENT TO PROVIDE
 LOCATIONS OR DIMENSIONS OF PROPERTY BOUNDARIES.



LEGEND

- SECTION CORNER AS NOTED
- POINT OF APPROPRIATION
- SECTION LINE
- 1/4 SECTION LINE
- 1/16 SECTION LINE
- 12" PVC MAINLINE
- WHEEL LINES
- PRIMARY RIGHTS T-7984
- SUPPLEMENTAL RIGHTS T-7984

RECEIVED
 AUG 30 2021
 OWRD

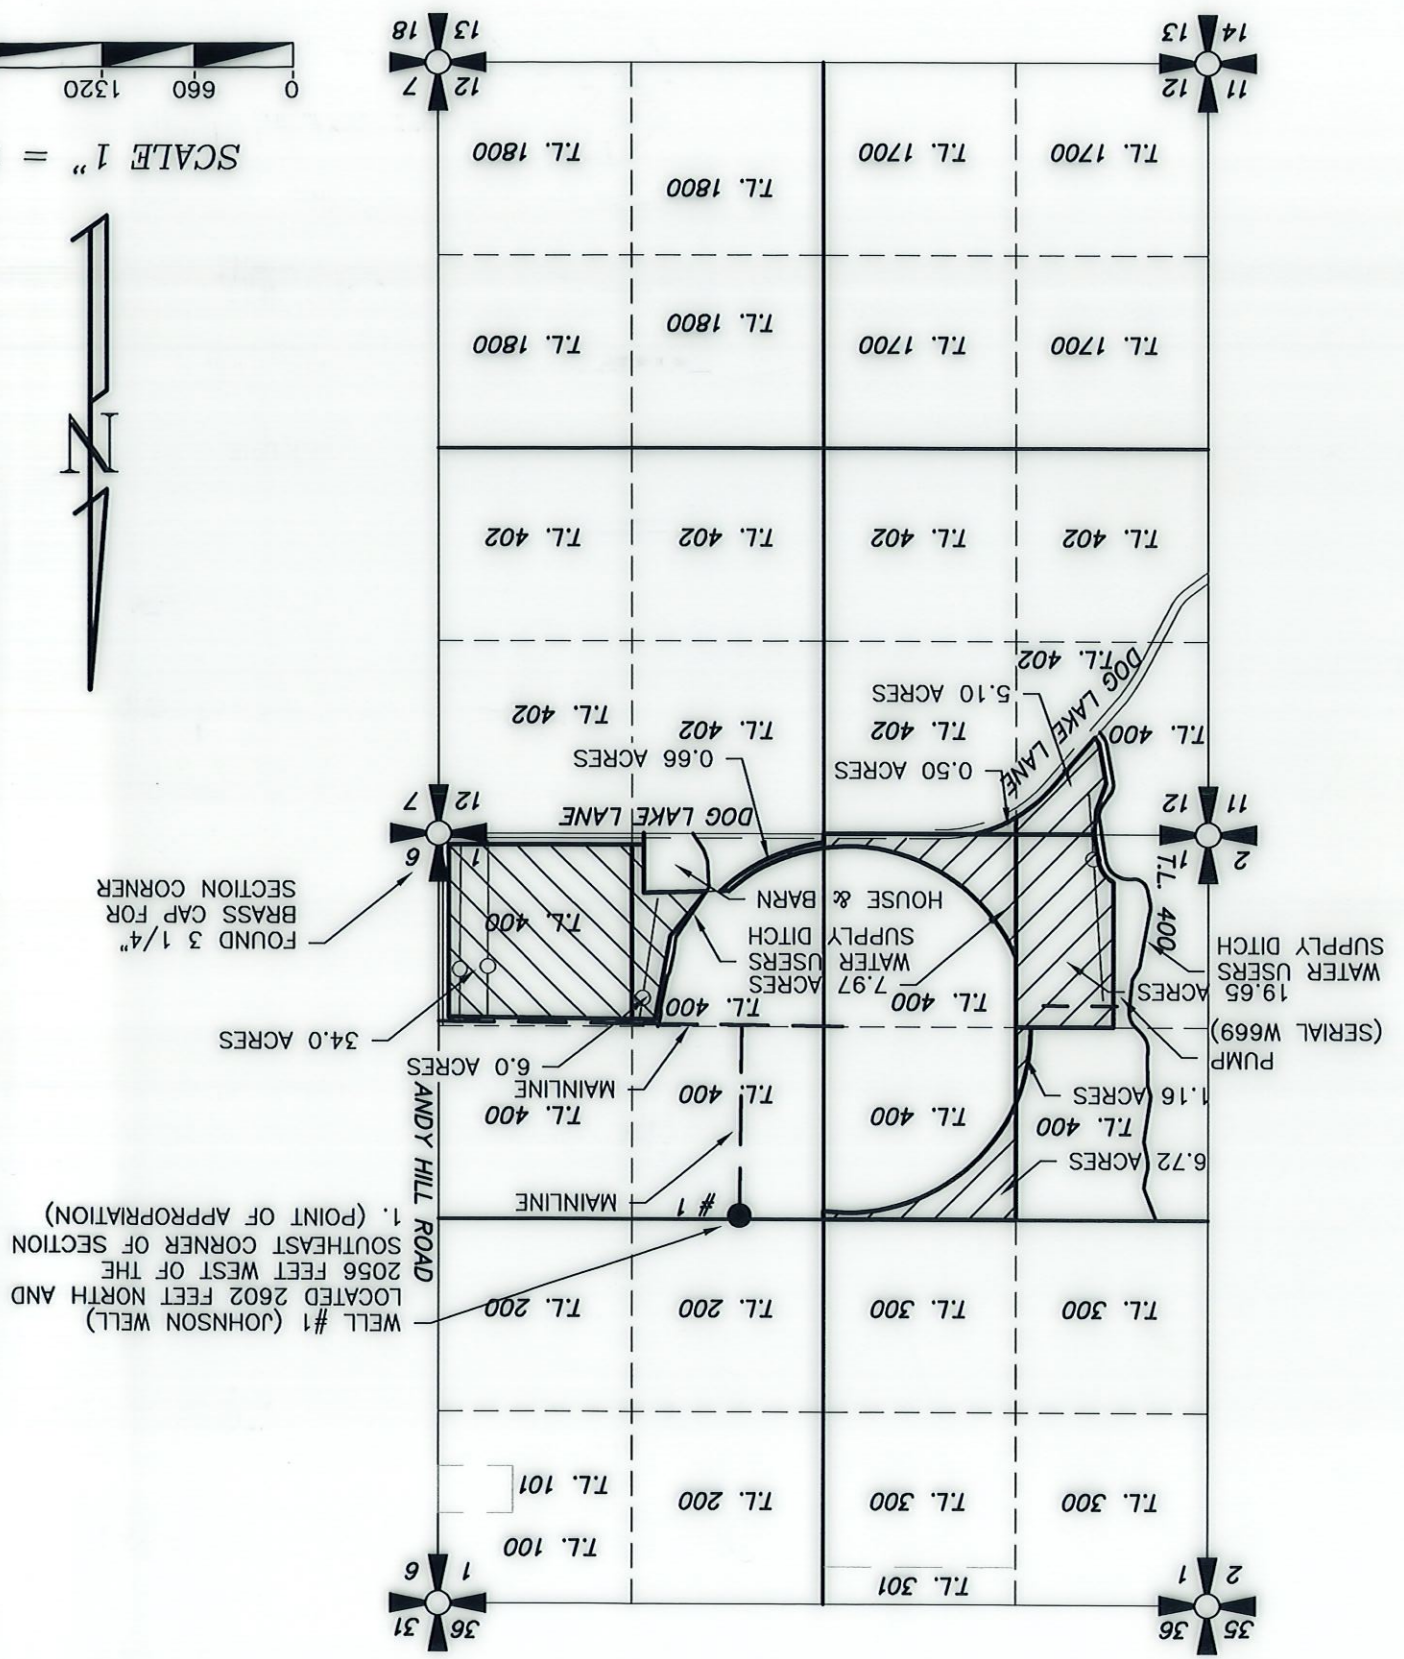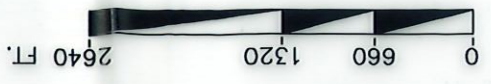

DATE: 8-24-2021
 SCALE: 1" = 1320'
 DWG. BY: Z.F.
 JOB: 2021-119
 FILE: 2021-119
 SHEET: A-1

C.O.B.U. KETCHAM TRUST
 TRANSFER T-7984
 LAKEVIEW, OREGON

FOR:
 KETCHAM TRUST
 9119 DOG LAKE LN
 LAKEVIEW, OR 97630
 (717) 847 4366

ANDERSON ENGINEERING AND SURVEYING, INC.
 P.O. BOX 28
 LAKEVIEW, OREGON 97630
 (541) 947-4407/FAX: 947-2321
 WWW.ANDERSONENGINEERING.COM

REVISION	BY