


Point of Beginning 503°01'31"E, 769.28' From NW Corner Sec 13

See Map 6N 35 440

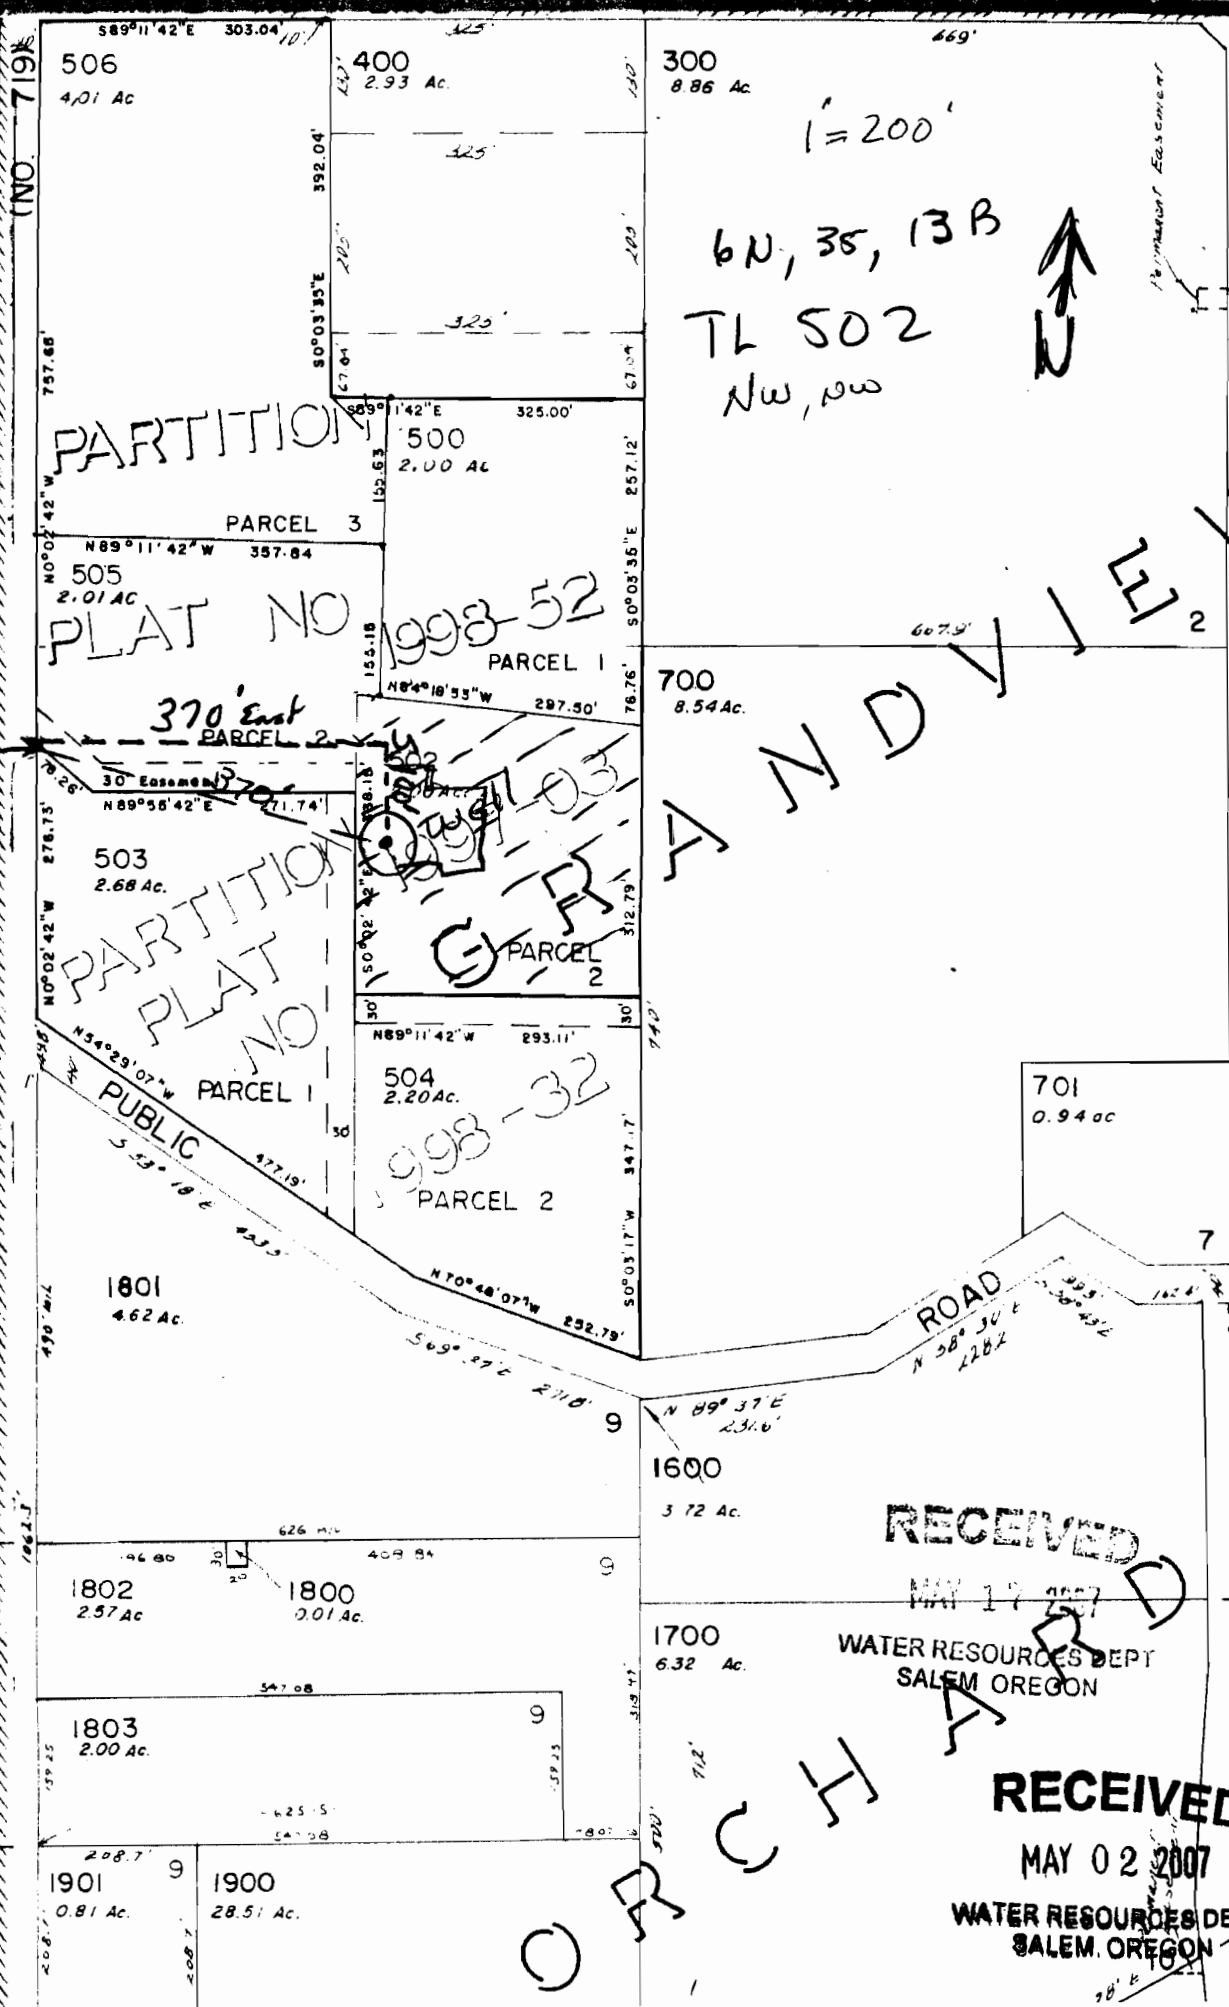

NO. I































RECEIVED
MAY 17 2007
WATER RESOURCES DEPT
SALEM OREGON

RECEIVED
MAY 02 2007
WATER RESOURCES DEPT
SALEM OREGON

GRANDVIEW
