Claim of Beneficial Use - Kropf
Application S-88197, Permit S-55007

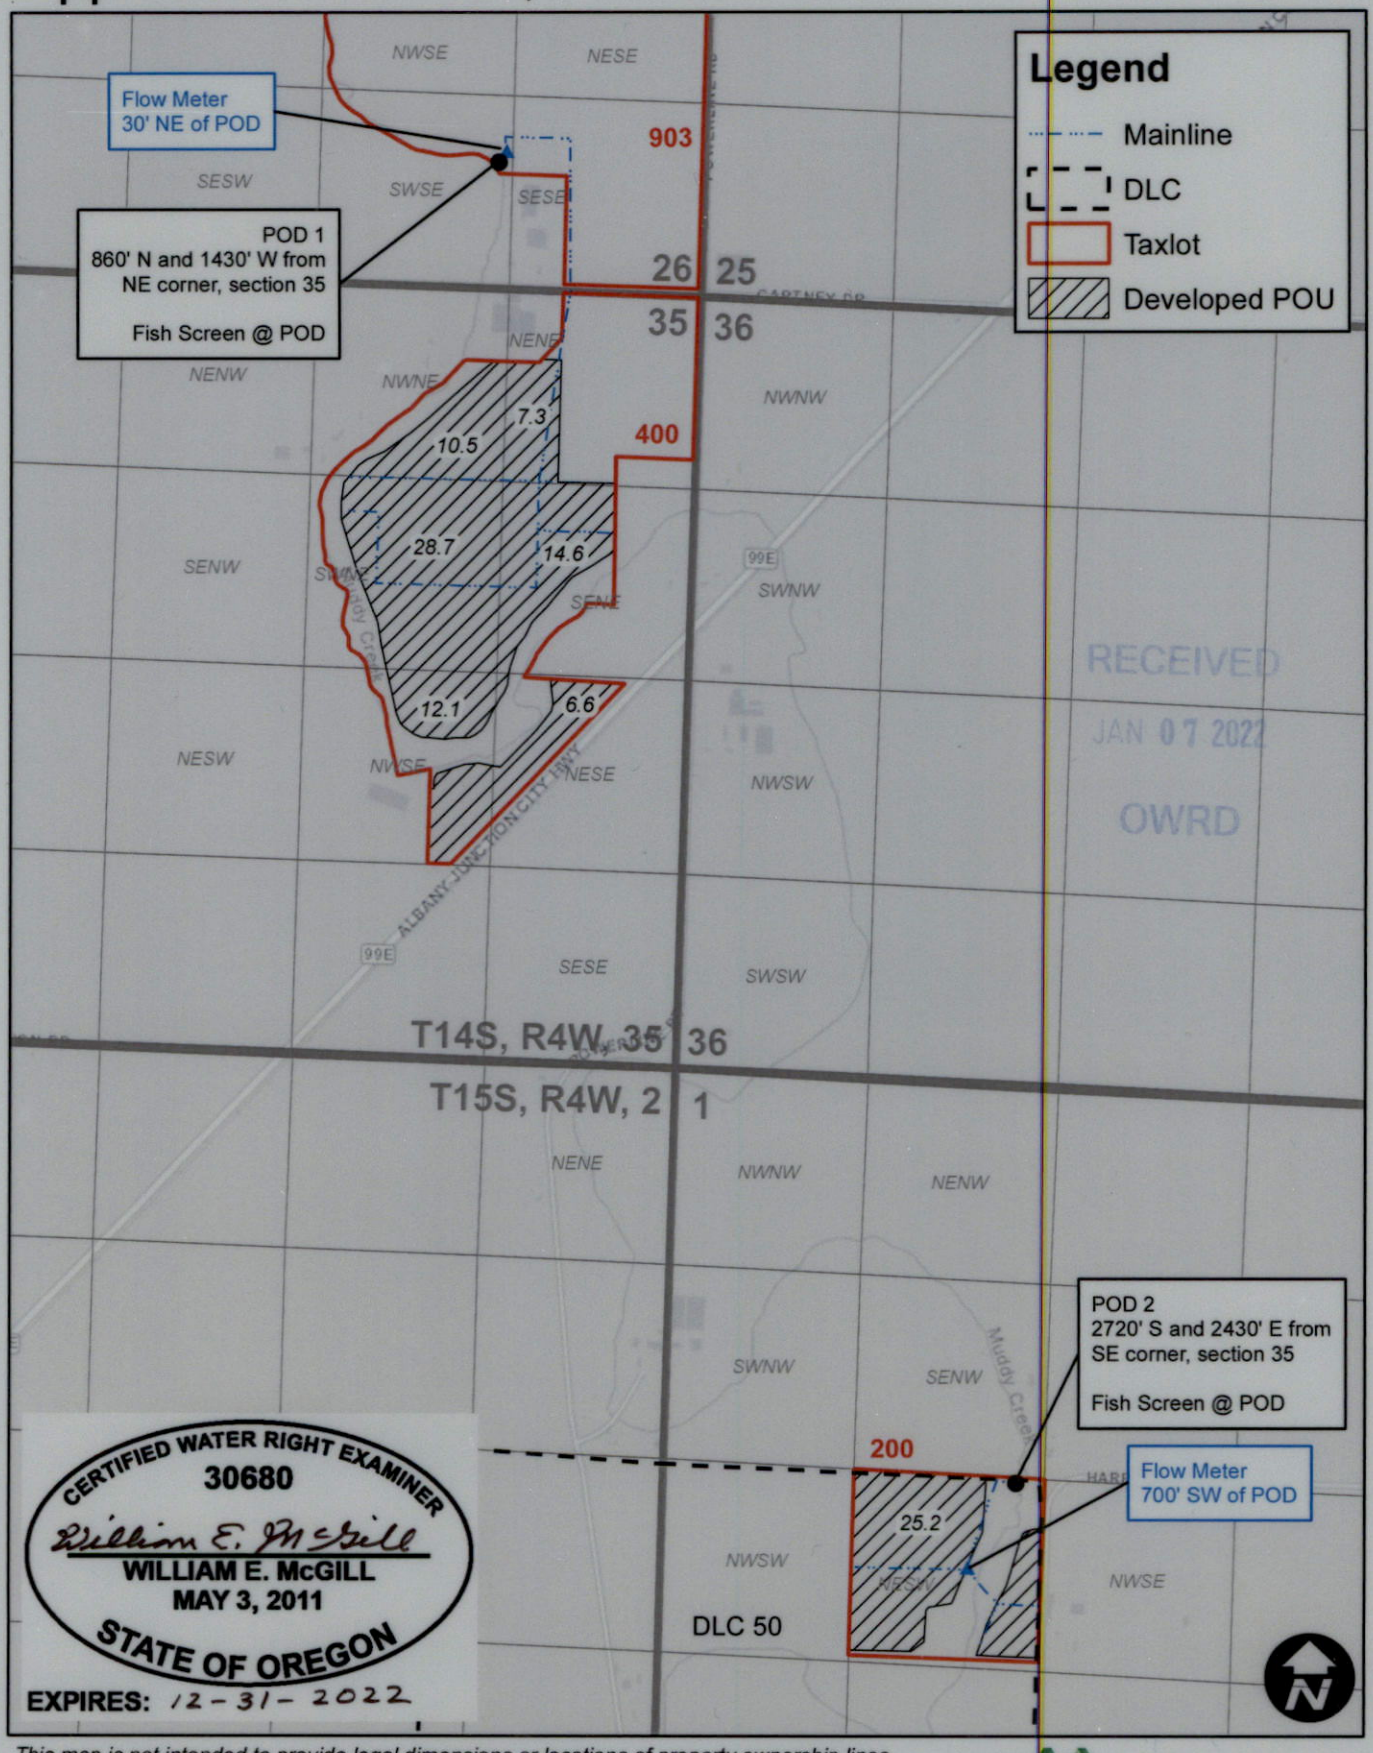

This map is not intended to provide legal dimensions or locations of property ownership lines.

0 1,320 2,640 5,280 Feet

WILL MCGILL SURVEYING LLC