

From: Eldon Metz eldon@metzhome.us
Subject: Scannable Document - sent from Scannable
Date: December 22, 2021 at 10:25 AM
To: Eldon Metz eldon@metzhome.us

RECEIVED

JAN 13 2022

OWRD

RECEIVED

DEC 27 2021

OWRD

EM


Eldon

Eldon Metz, Cascade Buffalo Ranch

1" = 1320'

Tax Lot: 300

Township 8 South, Range 1 West, Section 8

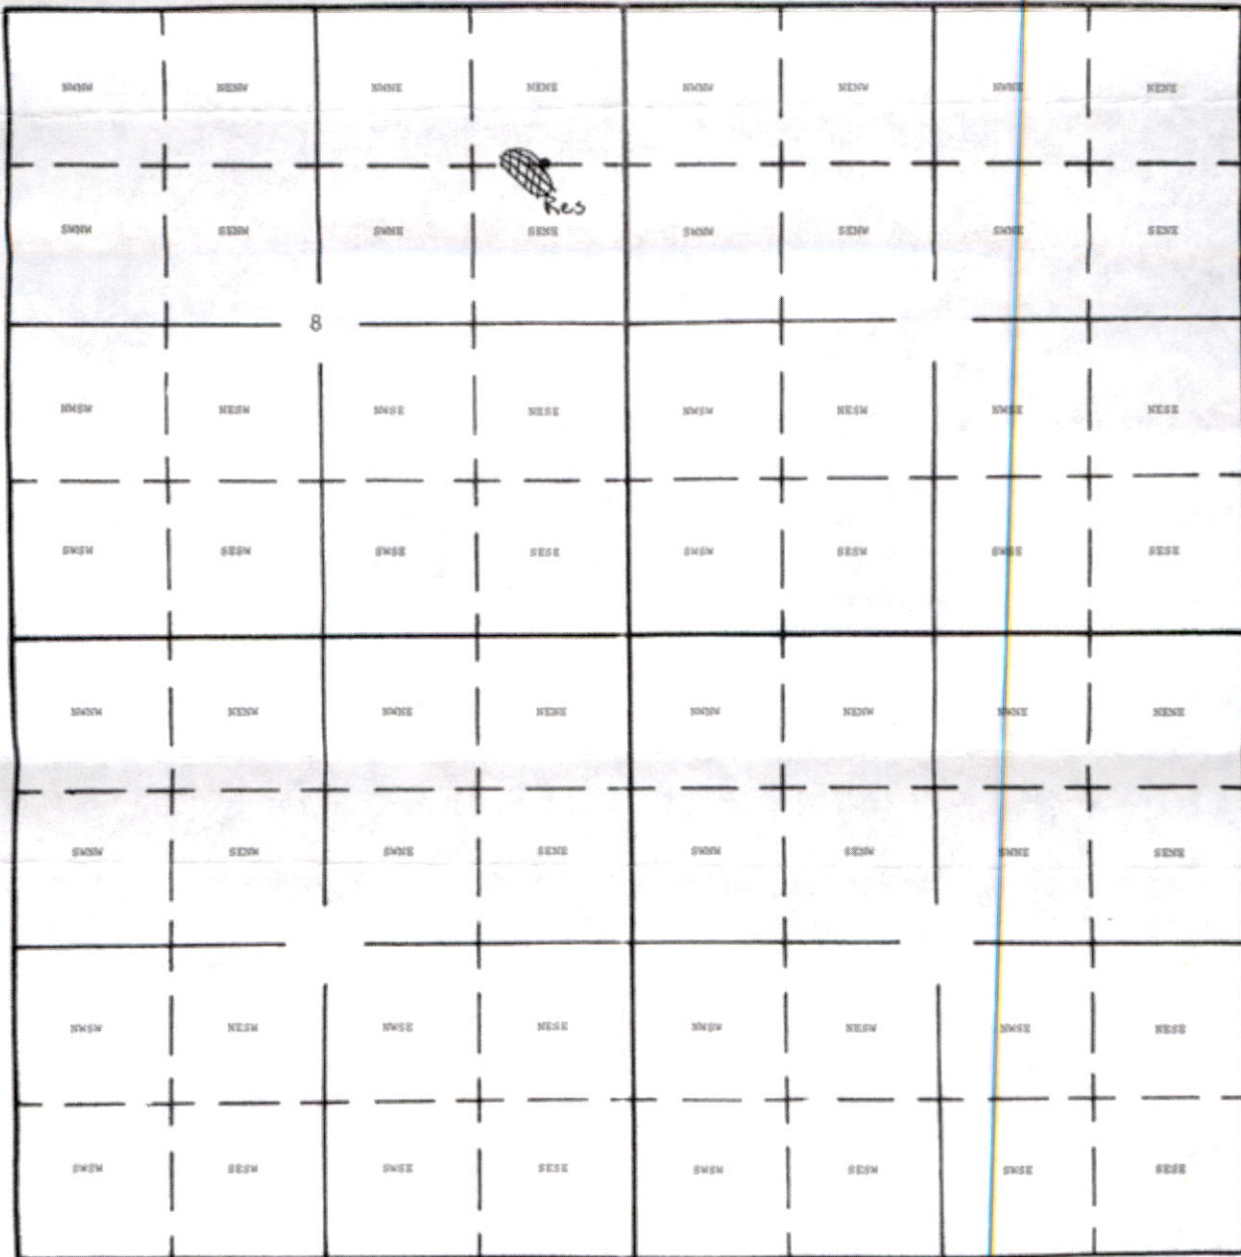

Center of Dam: 1320 Feet South and 700 Feet West from the NE Corner Section 8

RECEIVED BY OWRI