

T38S R5W Sec32

RECEIVED


JUN 04 2020

OWRD

RECEIVED

JAN 24 2022

OWRD

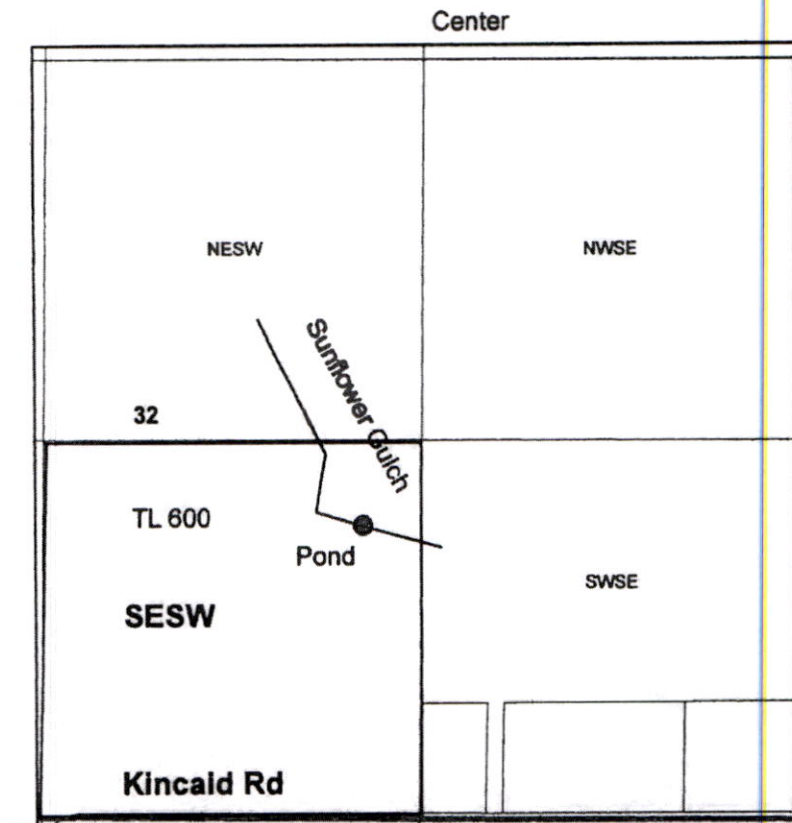

1 inch = 660 feet

Pond is 1646 ft south and 215 ft west from center Sec 32.

RECEIVED BY OWRD


JUN 12 2015

SALEM, OR

JUN 01 2015

SALEM, OR

R-88027 R-15140

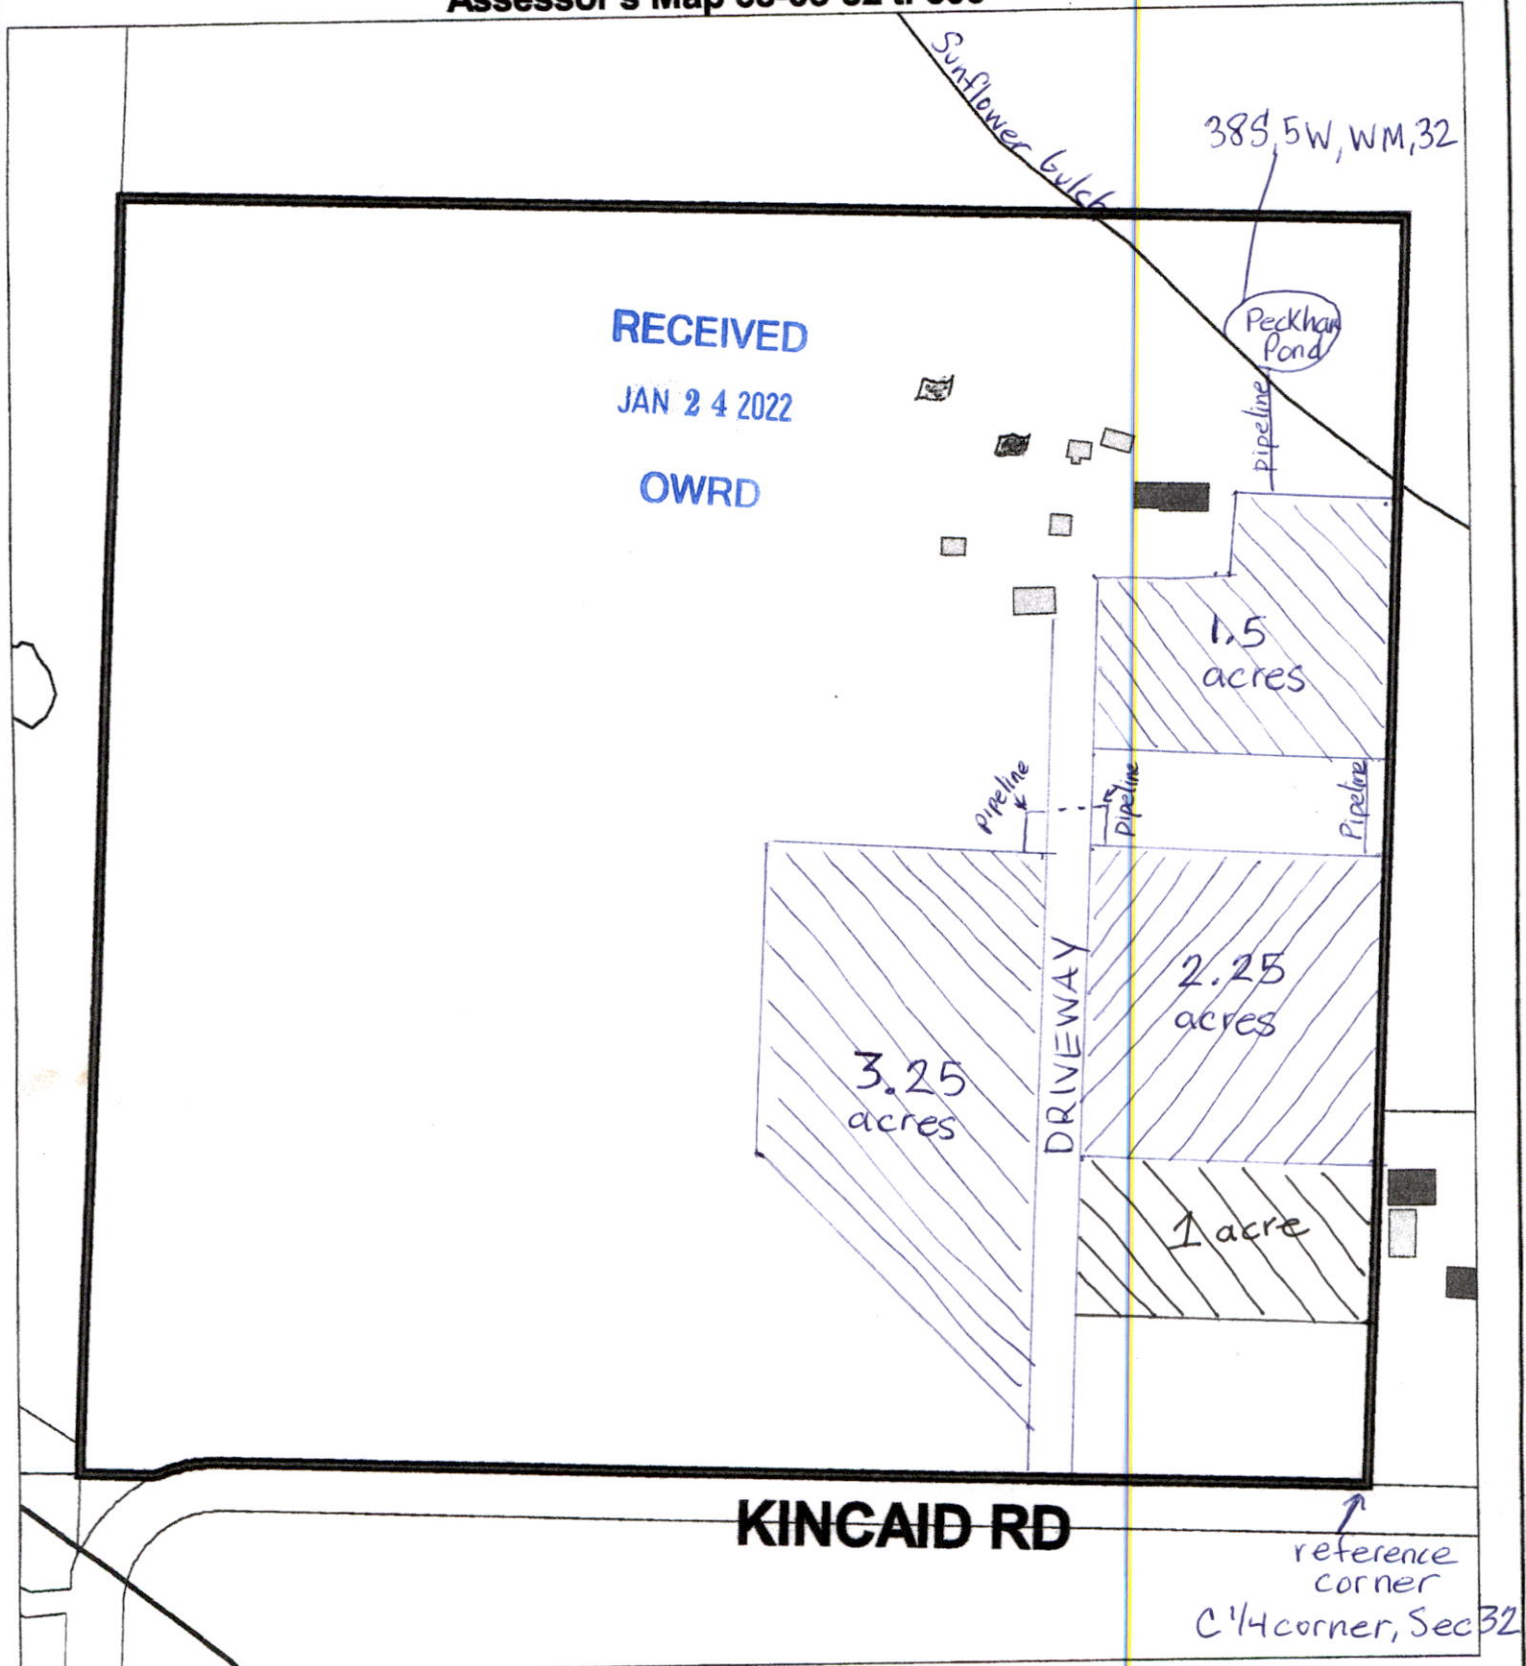

Legend

- Buildings**
- PRIMARY
 - SECONDARY
 - Taxlots
- Water (line)**
- Class 1
 - Class 2




The information on this map is furnished for general interest purposes only. This information is provided without warranties of any kind, express or implied, and it should not be used to support any purchase or other investment. Neither Josephine County, Cave Junction, nor Grants Pass will accept responsibility for any errors or inaccuracies in the depicted information.



Scale
1:2400



Locator Map

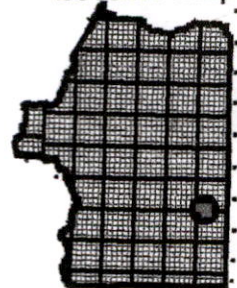


Permit: S 18132
Volume: 6B
Strm: SUNFLOWER G
Trib: MULE G
Priority: 1/13/48

*Sketched from app. map
increase from proof.*

RECEIVED

JAN 24 2022

OWRD

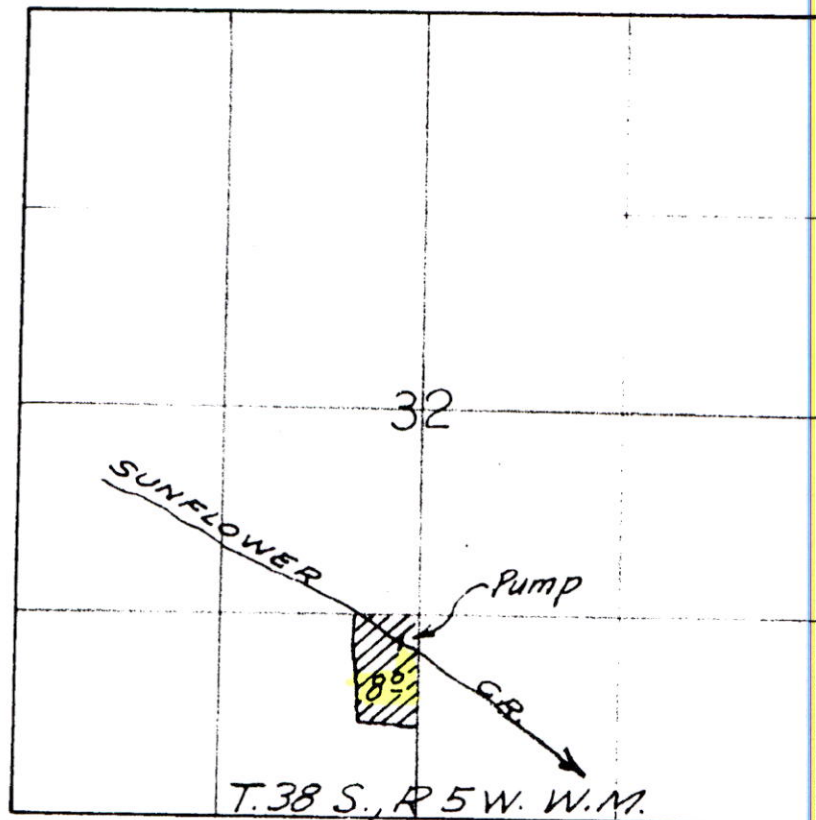

App 22987

OWRD

STATE ENGINEER
SALEM, OREGON

