

THIS MAP WAS PREPARED FOR ASSESSMENT PURPOSE ONLY.

SEC.26 T30S. R.4W. W.M.  
DOUGLAS COUNTY  
1" = 400'

*P = pump*  
*[H] = house*  
*WT = water tank*

REVISED ON



30 4 26


RECEIVED

DEC 01 2021

OWRD

CANCELLED NOS  
200M1 200M2 500M1

*POD*  
*460' South*  
*600' West*  
*NE Corner*  
*of Section 26*

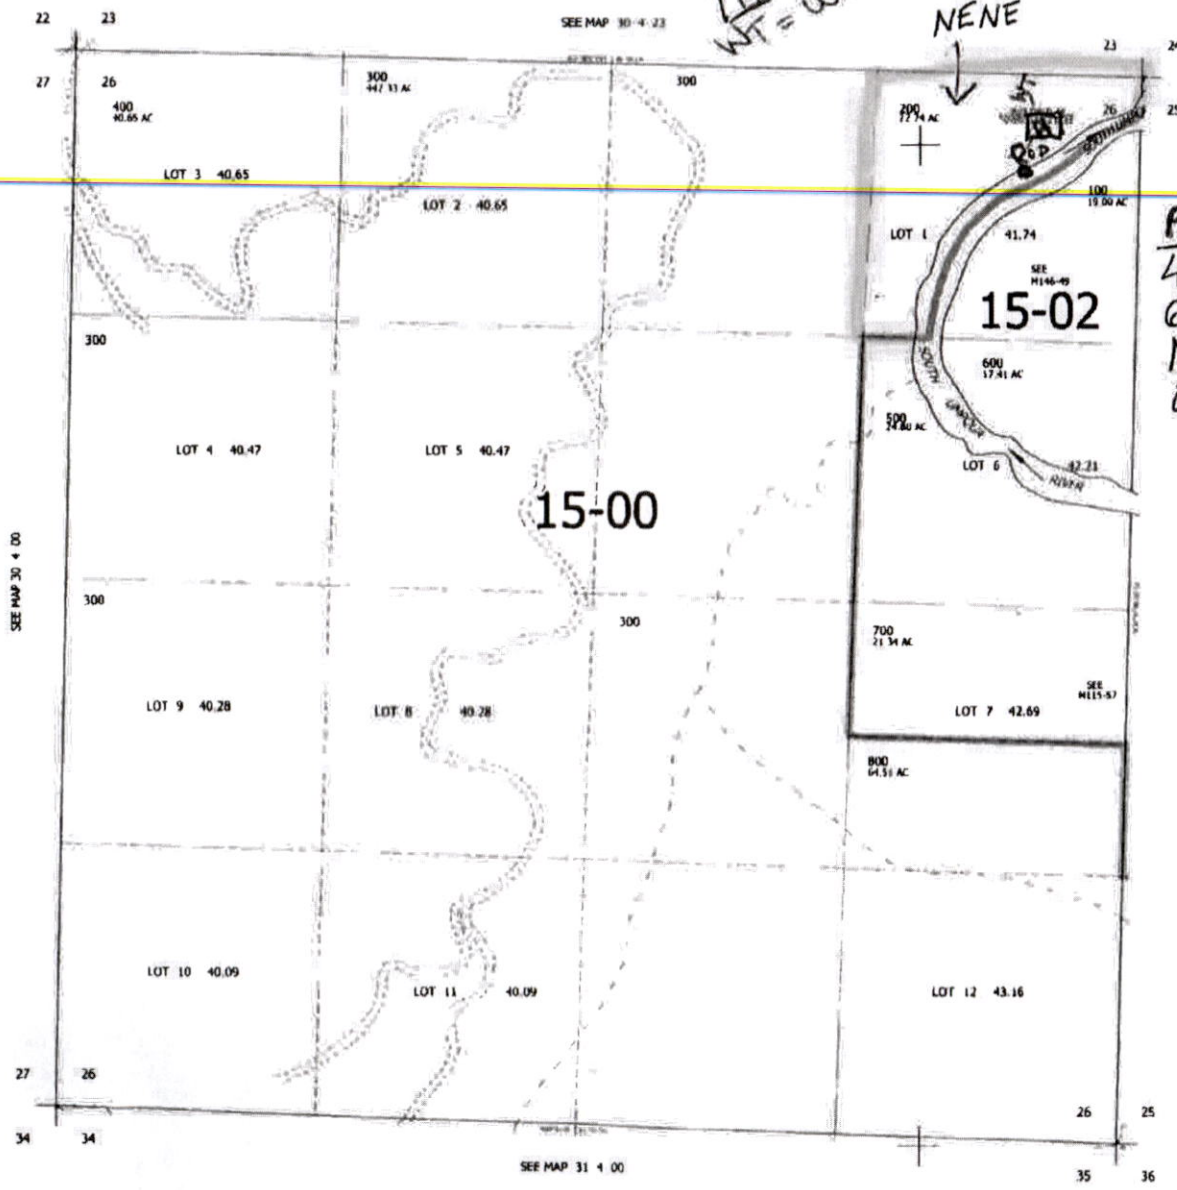

RECEIVED

JAN 26 2022

OWRD

30 4 26

THIS MAP WAS PREPARED FOR ASSESSMENT PURPOSE ONLY.

SEC. 26 T30S. R. 4W. W.M.  
DOUGLAS COUNTY  
1" = 400'

REVISED ON  
P = pump  
H = house  
WT = water tank



30 4 26


RECEIVED

DEC 01 2021

OWRD

CANCELLED NOS  

Pod  
460' South  
600' West  
NE Corner  
of Section 26

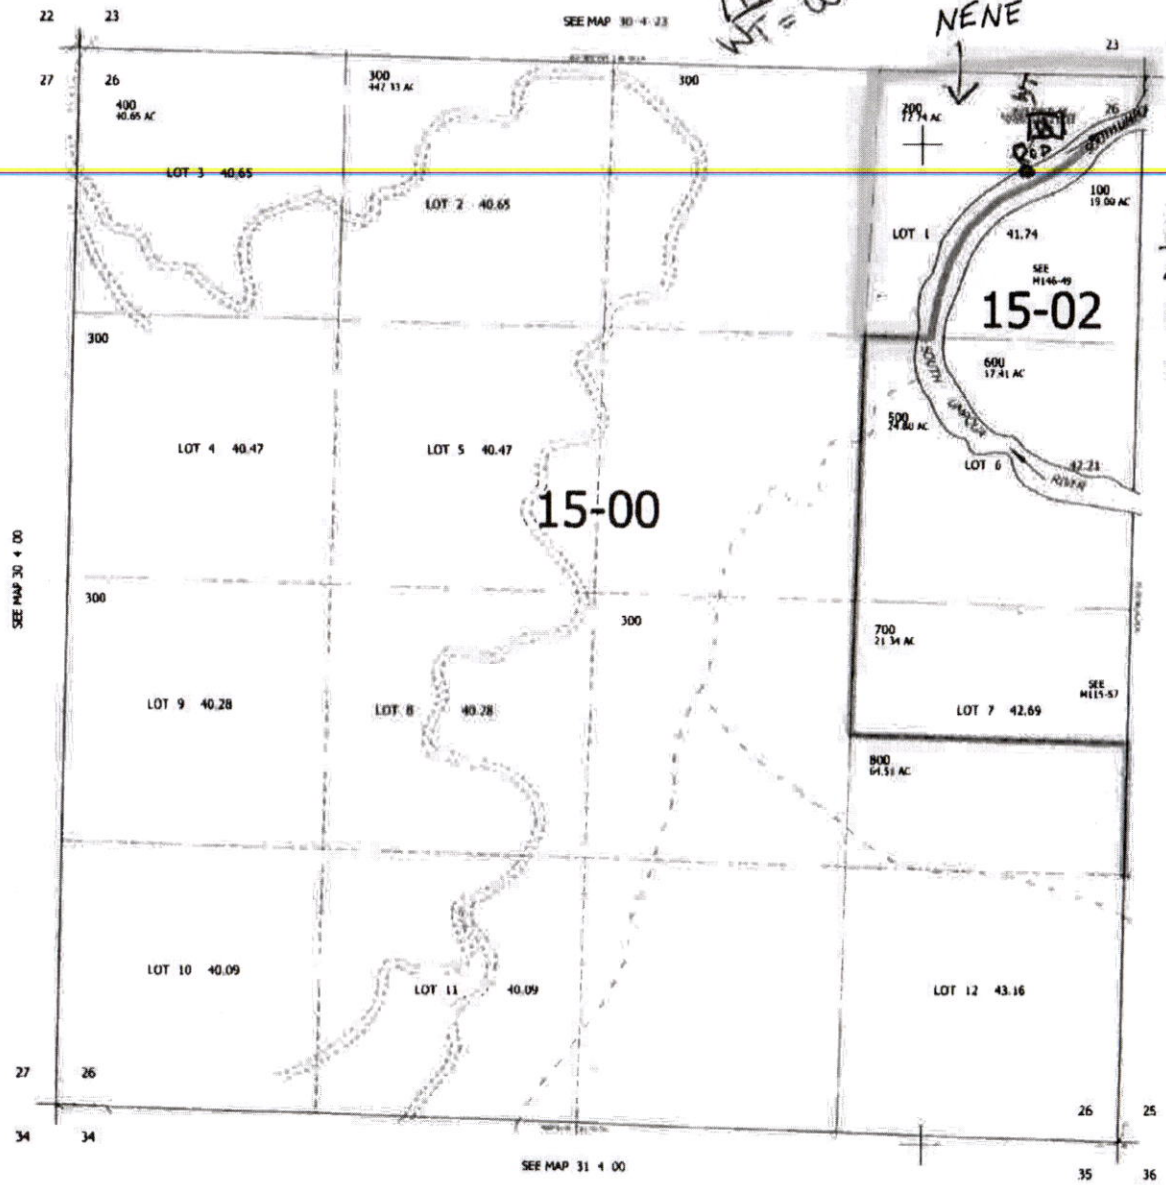

RECEIVED

JAN 26 2022

OWRD

30 4 26

THIS MAP WAS PREPARED FOR ASSESSMENT PURPOSE ONLY.

SEC.26 T30S. R.4W. W.M.  
DOUGLAS COUNTY  
1" = 400'

REVISED ON

30 4 26

*P = pump  
H = house  
WT = water tank*




RECEIVED

DEC 01 2021

OWRD

CANCELLED NO'S  
200M1 200M2 500M1

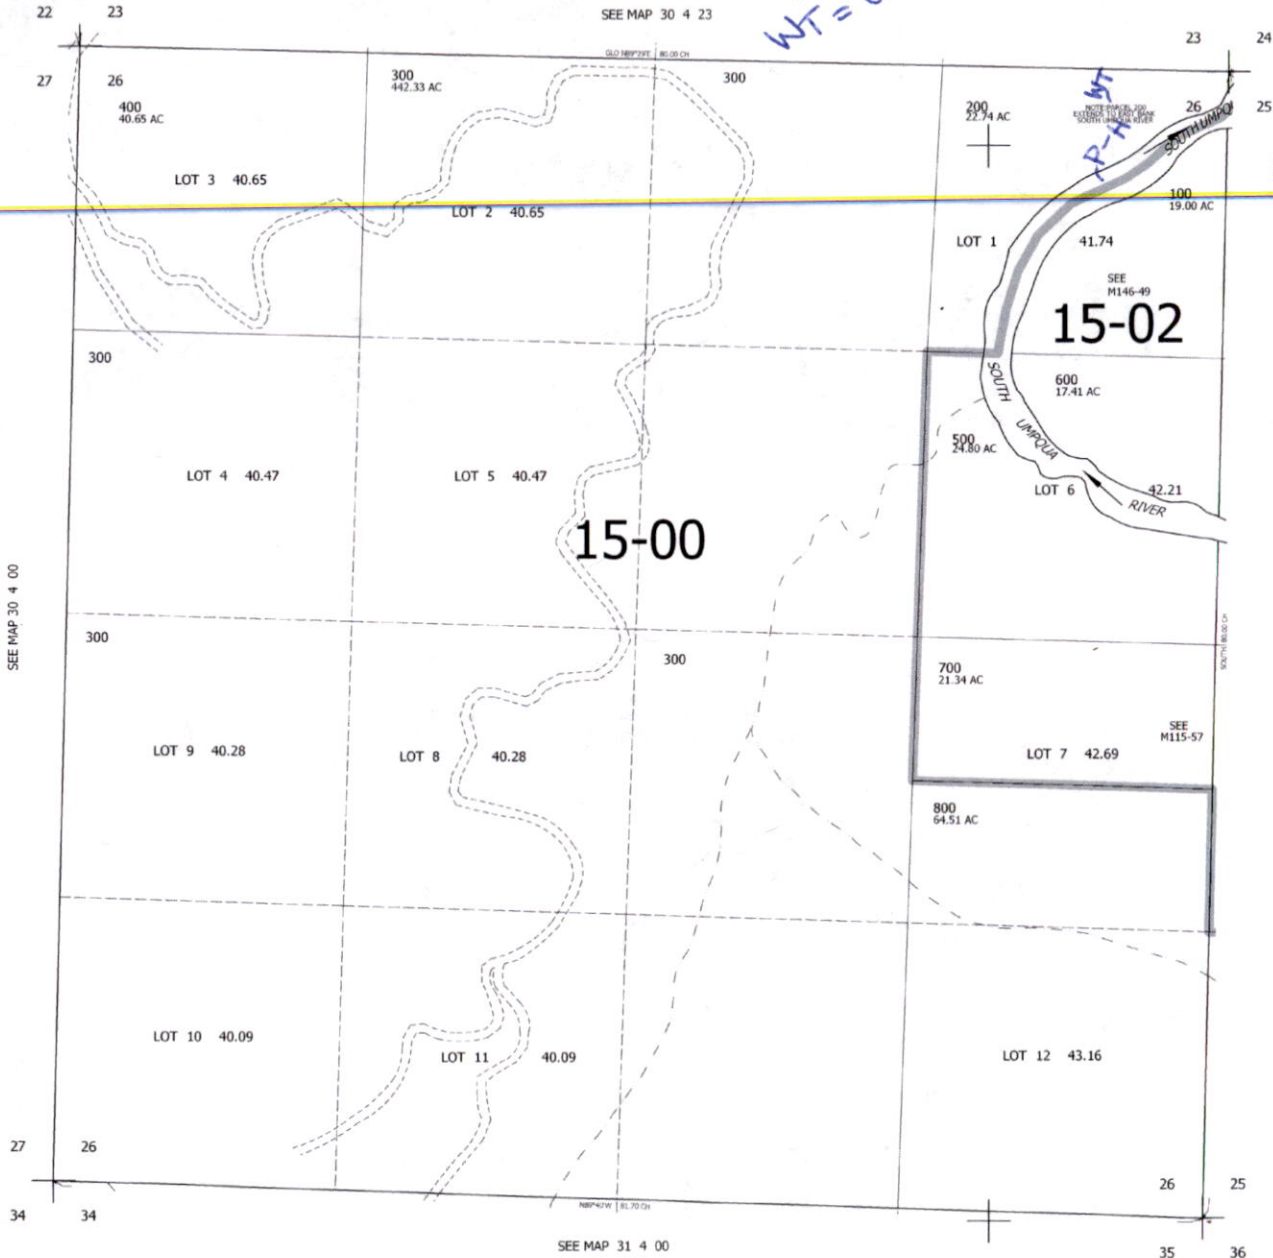

RECEIVED

JAN 26 2022

OWRD

30 4 26

4,216,000

470,000