

**CLAIM OF
BENEFICIAL USE
for Reservoirs storing less than
9.2 acre-feet permitted under
ORS 537.409**



Oregon Water Resources Department
725 Summer Street NE, Suite A
Salem, Oregon 97301-1266
(503) 986-0900
www.wrd.state.or.us

RECEIVED

JUN 12 2018

OWRD

**A fee of \$200 must accompany this form.
The Claim will be returned if the fee is not included.
Claims received without the correct fee of \$200 will be returned.**

This form may be completed by the permit holder of record if:

- 1) The permit was issued under the authority of ORS 537.409.**
- 2) No secondary permit exists for the use of water stored in the reservoir.**
- 3) The developed capacity of the reservoir is less than 9.2 acre-feet.**
- 4) The water was stored by the date required in the permit.**

A separate form shall be completed for each permit.

This form must be submitted to the Water Resources Department within one year of storage of water in the reservoir.

Please type or print in dark ink. If the data provided is found to contain errors or omissions, it may be returned. The Department may require the submittal of additional information.

If you have questions regarding the completion of this form, please call 503-986-0900 and ask for the Certificate Section.

**SECTION 1
GENERAL INFORMATION**

RECEIVED

JUN 12 2018

OWRD

File Information

APPLICATION #	PERMIT #
R-88094	R-15145

Applicant Information

APPLICANT NAME Boyd K. Follett		PHONE NO. 541-437-1352	ADDITIONAL CONTACT NO. 541-786-2297	
ADDRESS P.O. Box 810				
CITY Elgin	STATE OR	ZIP 97827	E-MAIL bkfollett@gmail.com	

SECTION 2

RESERVOIR INFORMATION

Reservoir Dimensions and Capacity

AVERAGE LENGTH	AVERAGE WIDTH	AVERAGE DEPTH	MAXIMUM CAPACITY IN ACRE-FEET
139'	171'	12'	5.76

To determine capacity in acre-feet use for the above table, use the following calculation:

$$\text{Acre-feet} = \frac{(\text{Average Length})(\text{Average Width})(\text{Average Depth})}{43,560}$$

RECEIVED

JUN 12 2018

SECTION 3

MAP

OWRD

Attach a map identifying the reservoir location. If the water right application map accurately reflects the location of the reservoir, you may attach a copy it. Otherwise, you must submit a map meeting the standards of OAR 690-310-0050, which are attached.


Preparation of the map by a Certified Water Rights Examiner is **not** required for this type of permit, but may be submitted.

SECTION 4


SIGNATURE

This Claim of Beneficial Use must be signed by each permit holder of record.

By my signature, I certify that the information contained herein is true and correct to the best of my knowledge.

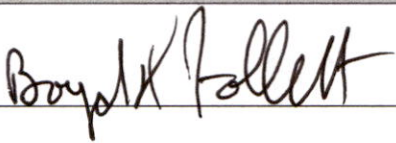SIGNATURE	PRINT OR TYPE NAME	TITLE	DATE
	Boyd K. Follett	Owner	6/4/2018


SCALE
1" = 800'

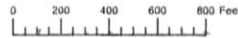

198 acres in
SECTION 12 T.1N. R.40E. W.M.
UNION COUNTY
1" = 400'

01N40E12

Cancelled
301
500

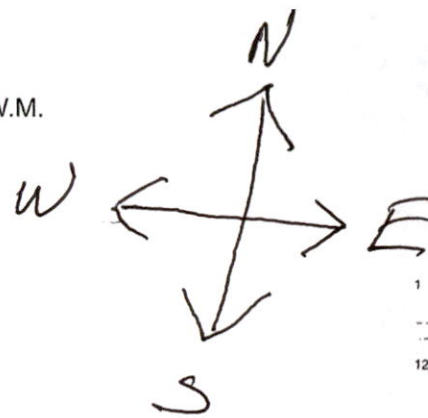

Application #
R 88094

Permit #
R 15145


Center of Pond


Latitude
45.585281

Longitude
117,763 437

RECEIVED
JUN 12 2018
OWRD

Boyd Follett
P.O. Box 810
Elsin, OR
92827

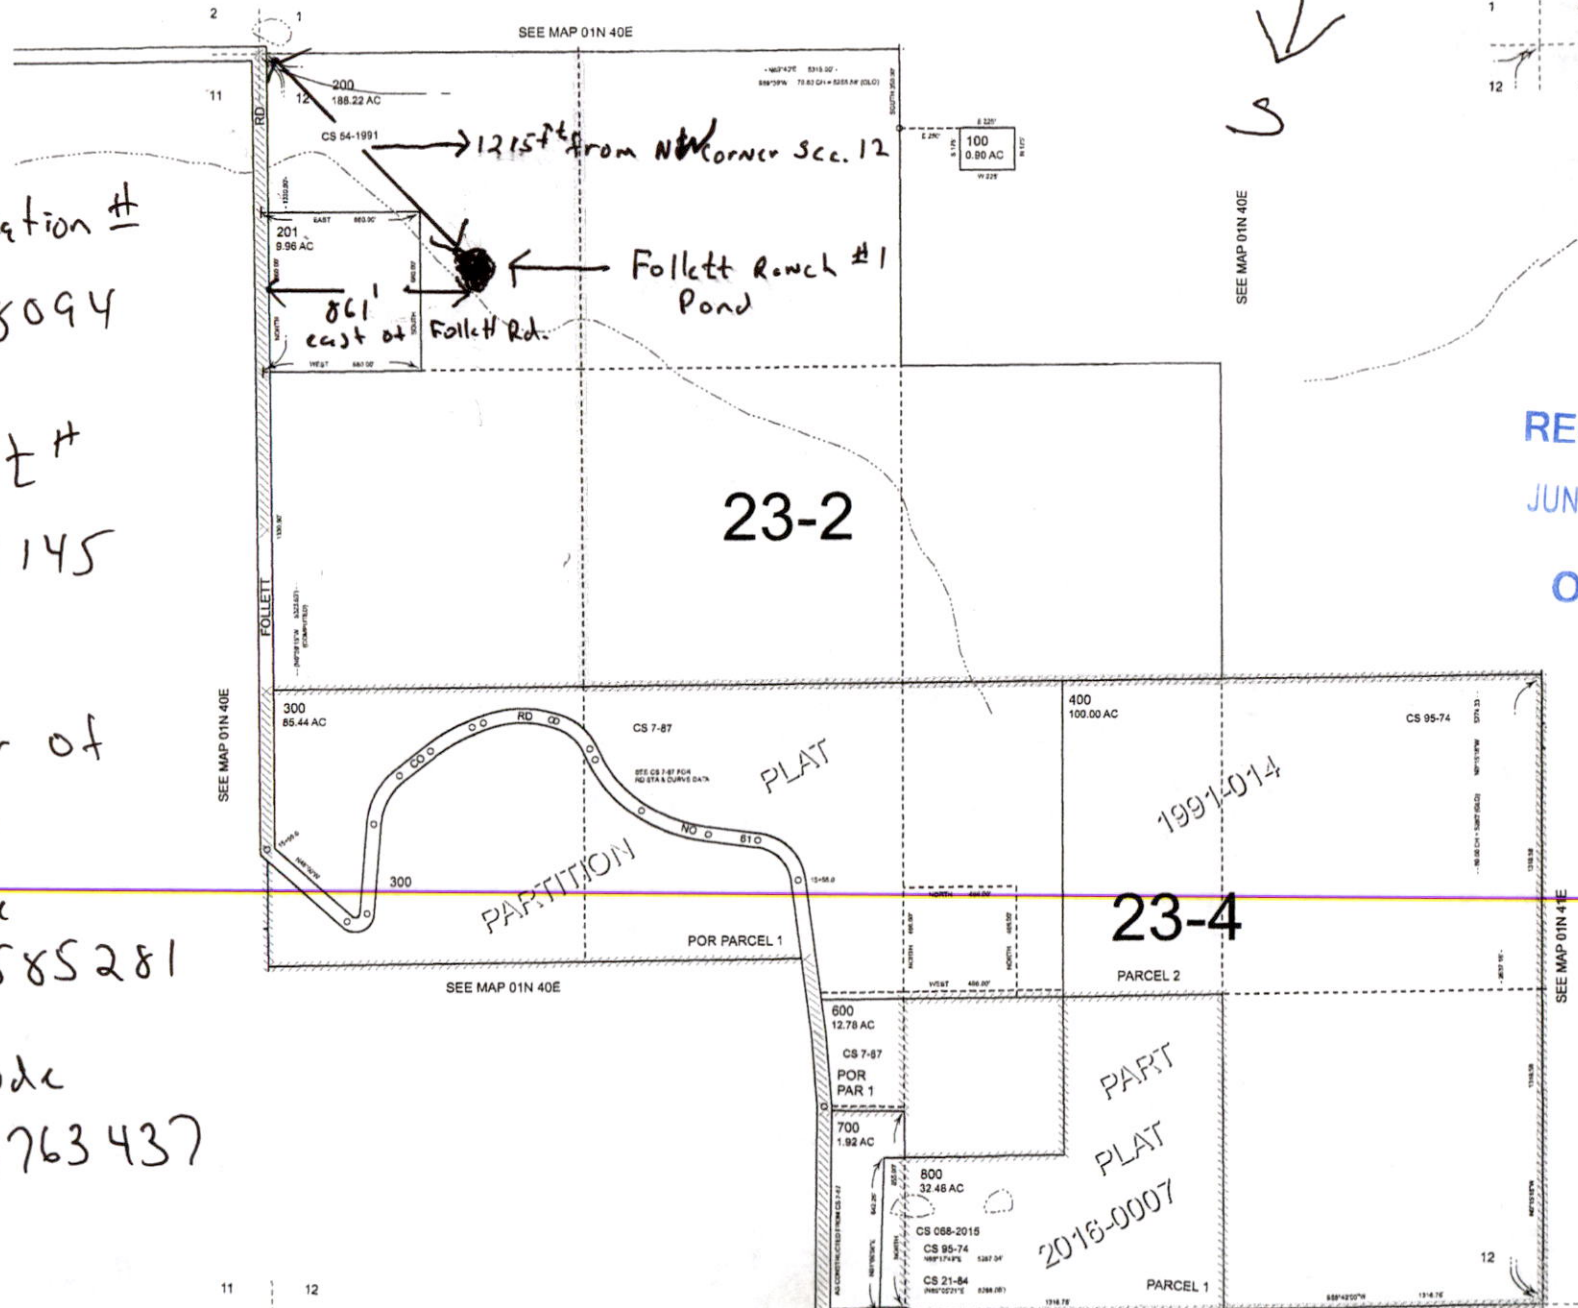

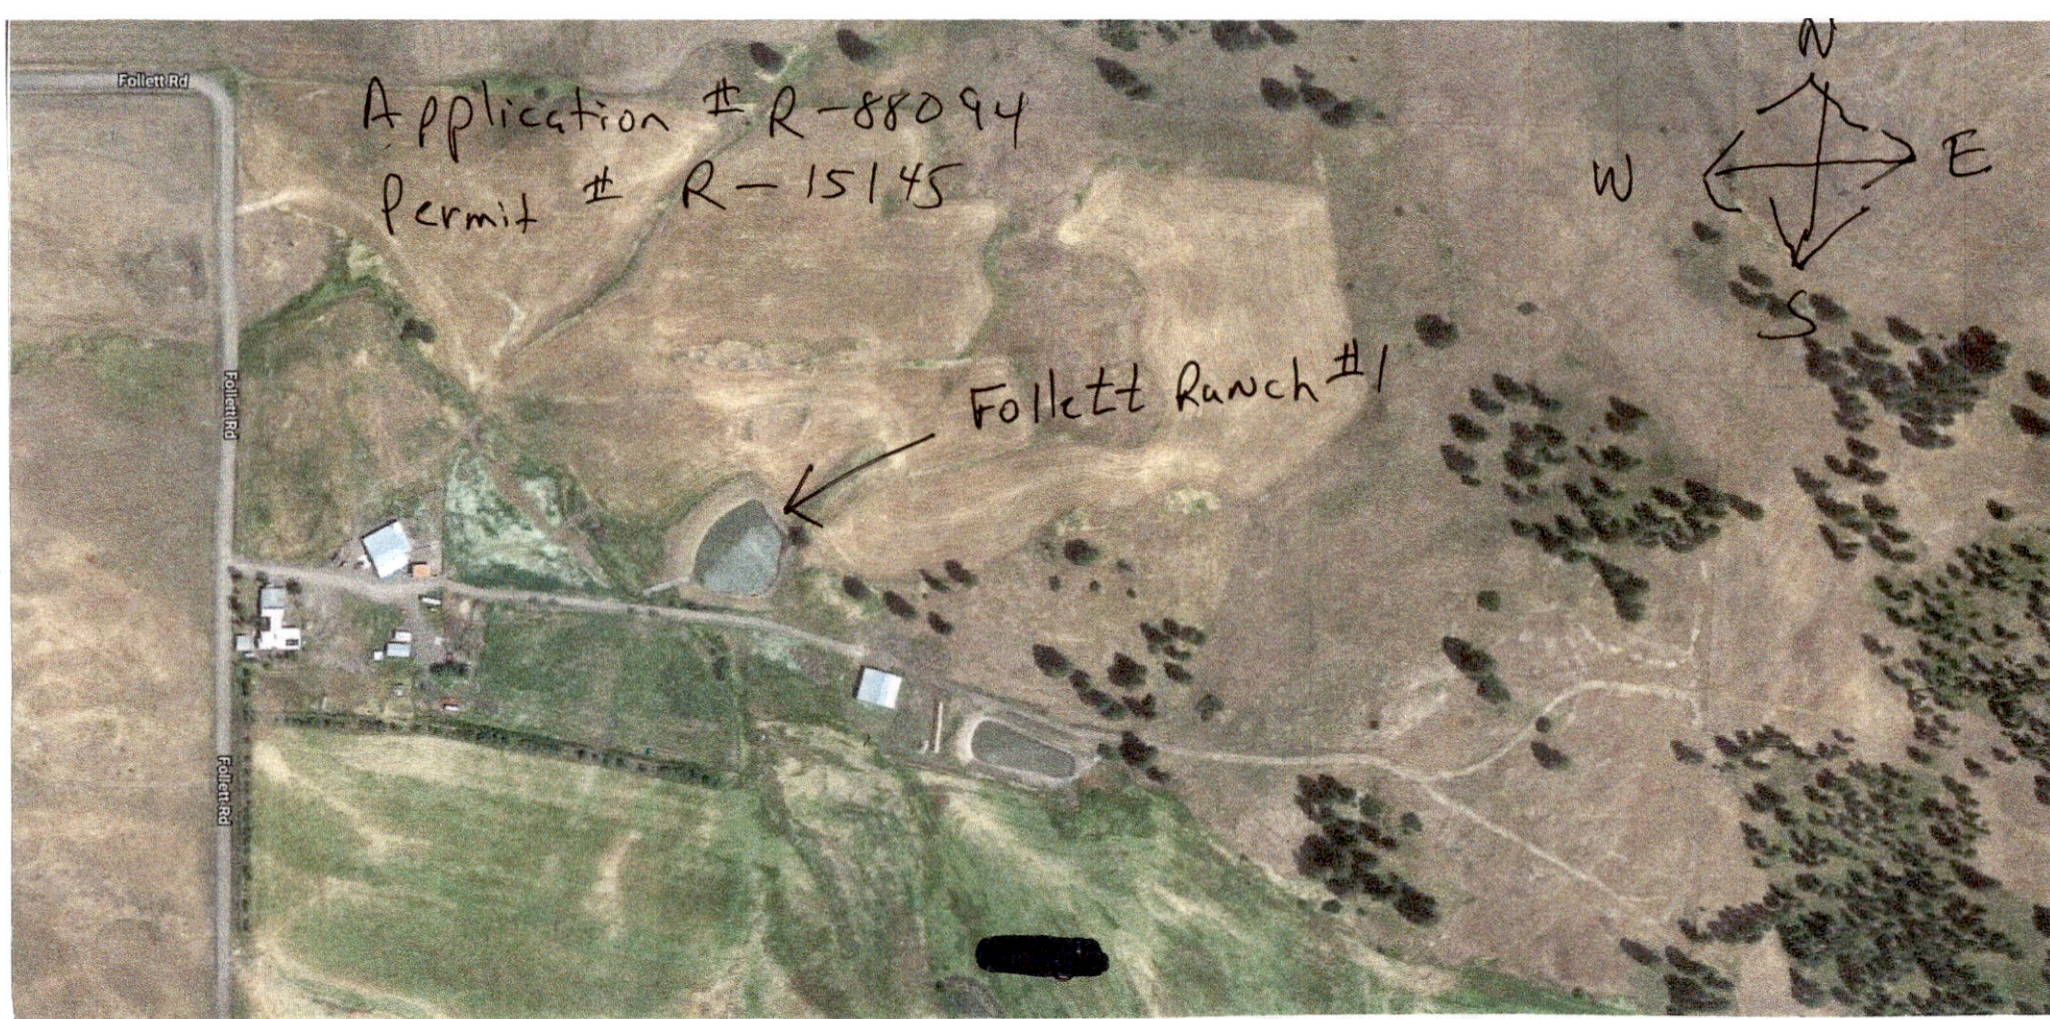

Middle of pond Latitude 45.585281 + Longitude 117.763437

1215' from ~~NEW~~ Corner Section 12, Township 1N, Range 40E Willamette Meridian
861' East of Follett Road which is western section line for Section 12
732' South of Northern section line for Section 17

RECEIVED

JUN 12 2018

Tax lot 200 in Union, County, OREGON - 198 acres OWRD