

CLAIM OF BENEFICIAL USE

TRANSFER T-13498

IN THE NAME OF MURPHY ELECTRIC IRRIGATION CO.

SECTION 20, TOWNSHIP 37 SOUTH, RANGE 5 WEST, W.M.

JOSEPHINE COUNTY OREGON

RECEIVED

FEB 04 2022

OWRD



Legend


Points of Diversion (of record) - #1 SE/NW Section 21, T37S, R5W, WM: 1550 feet South & 2200 feet East from the NW corner Section 21 (Not currently in use)

#2 SW/SW Section 6, T38S, R4W, WM: Northside Ditch - 950 feet North & 200 feet East from the SW corner Section 6

TL-302
Irrigation of 1.2 Acres (1899)
Joshua & Gretchen Ingersoll
7843 North Applegate Road
Grants Pass, OR 97527

Buildings


Murphy Electric Irrigation, Inc.
8227 New Hope Road
Grants Pass, OR 97527

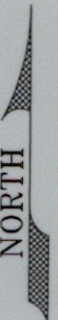

Base map Josephine County GIS Tax Lots over 9-22-21 Oregon
Map aerial photo & 10-25-20 Google aerial photo
for assumed best fit

Scale

1 inch = 1320 feet

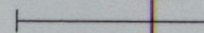

JORDAN ENGINEERING
460 JORDAN LANE
ROSEBURG, OR 97471
(541) 673-1931

This map is not intended to provide legal dimensions
or locations of property ownership lines

9/27/21 - n.e.d.