


Township 2 N, Range 32 E, Section 27

Odman Portion of Application G 14337, T 12588, Permit G 18025

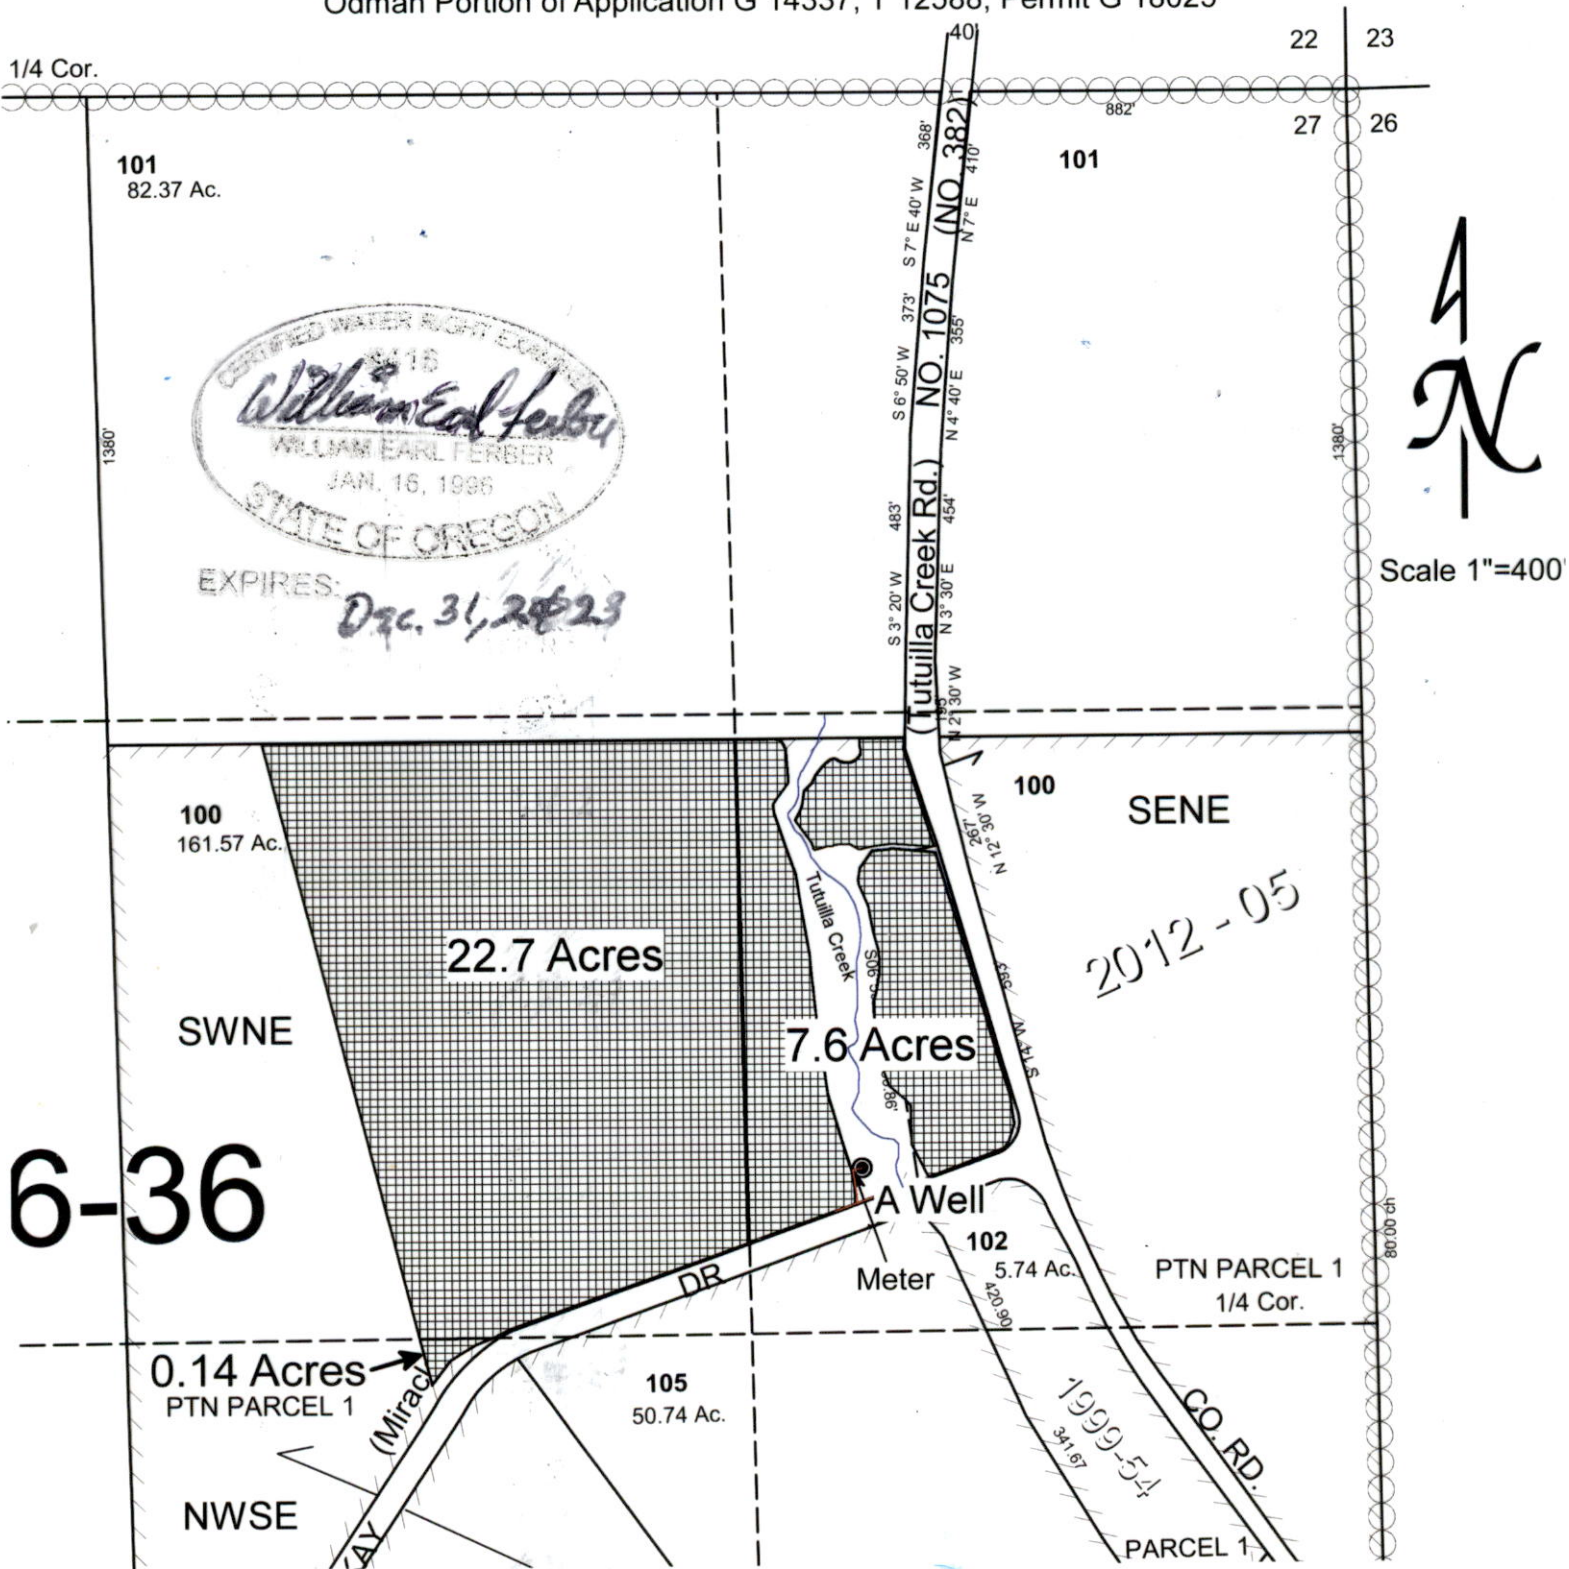

Legend

BK Water Right Consulting, LLC
PO Box 13434
Salem, Oregon 97309

- Mainline
- POA - Located 340' N and 1550' E of the Center 1/4 Corner of Section 27

This map is not intended to provide legal dimensions or locations of property ownership lines.

RECEIVED

FEB 09 2022

OWRD