

LEGEND



	RANGE LINE	TL 0000	TAX LOT NUMBER		PRIMARY IRRIGATION UNDER CERTIFICATE 26808 & SUPPLEMENTAL IRRIGATION UNDER CERTIFICATE 52212
	SECTION LINE		POA		PRIMARY IRRIGATION UNDER CERTIFICATE 26809 & SUPPLEMENTAL IRRIGATION UNDER CERTIFICATE 52212
	1/4 1/4 LINE		PRIMARY IRRIGATION UNDER CERTIFICATE 26808		
	TAX LOT LINE		PRIMARY IRRIGATION UNDER CERTIFICATE 26809		
	BURIED PIPE		PRIMARY IRRIGATION UNDER CERTIFICATE 34767		
	ROAD				
	DITCH/CANAL				
	SECTION CORNER				

NOTES:

- THIS MAP WAS PREPARED FROM FIELD MEASUREMENTS, NAIP 2022 AERIAL PHOTOGRAPHY, KLAMATH COUNTY TAX MAPS, AND OREGON GLO MAPS.
- THE PURPOSE OF THIS MAP IS TO IDENTIFY THE LOCATION OF THE WATER RIGHT ONLY, AND IS NOT INTENDED TO PROVIDE DIMENSIONS OR LOCATION OF PROPERTY LINES.
- DATES OF PRIORITY FOR THESE CERTIFICATES IS AS FOLLOWS:
 - CERTIFICATE 26808: SEPTEMBER 2, 1949
 - CERTIFICATE 26809: OCTOBER 30, 1952
 - CERTIFICATE 34767: OCTOBER 25, 1961
 - CERTIFICATE 52212: SEPTEMBER 22, 1975

WELLS & POD LOCATIONS:

AOA-1 (KLAM 14735): 1330' SOUTH & 770' WEST FROM THE NORTHEAST CORNER OF SECTION 12.
 AOA-2 (KLAM 14809): 18.5 CHAINS SOUTH & 19.5 CHAINS WEST FROM THE NORTHEAST CORNER OF SECTION 18.
 POD-1: 1100' SOUTH AND 320' WEST FROM THE NORTHEAST CORNER OF SECTION 18.

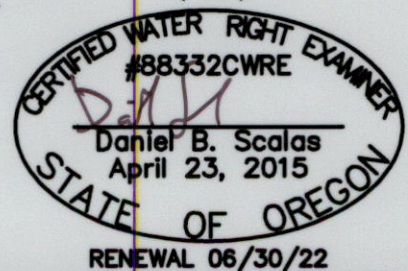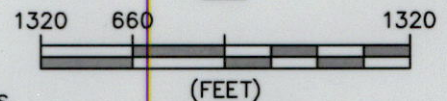

AL ADKINS
 ENGINEERING & SURVEYING
 o / 541.884.4666
 w / AdkinsEngineering.com

1435 ESPLANADE AVENUE, KLAMATH FALLS, OR 97601

SERVING S. OREGON & N. CALIFORNIA

ENGINEERING • SURVEYING • PLANNING • TESTING

CLAIM OF BENEFICIAL USE AND FINAL PROOF MAP

FOR
 DOUBLE J FARMS, LLC
 T40S, R12E, SEC. 18, WM
 T40S, R11E, SECS. 1 & 12, WM
 KLAMATH COUNTY, OREGON
 TRANSFER T-8553

RECEIVED
 FEB 17 2022
 OWRD





















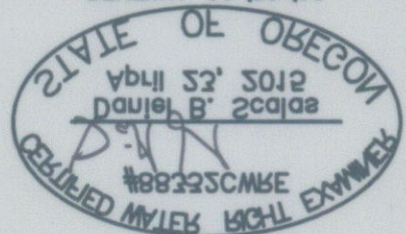

(FEET)

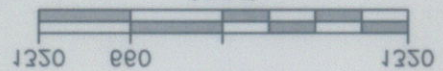




LEGEND

