
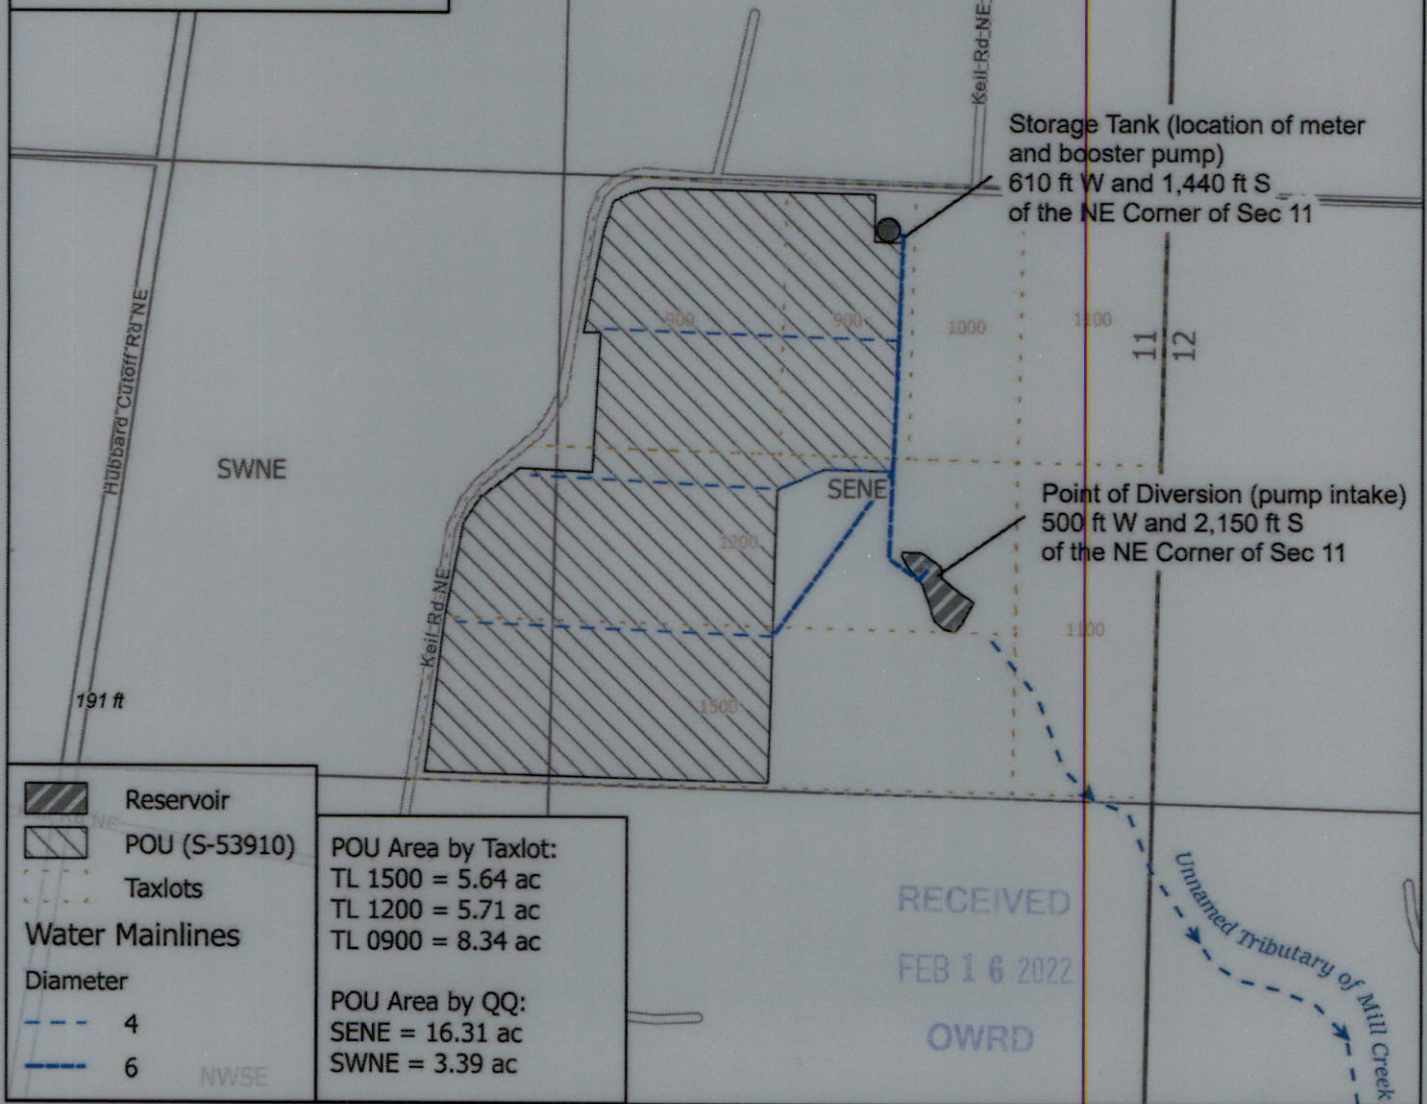


Claim of Beneficial Use Application Map
App. No. S-84720, Perm. No. S-53910
T2S, R1W, SENE and SWNE Section 11 W.M.

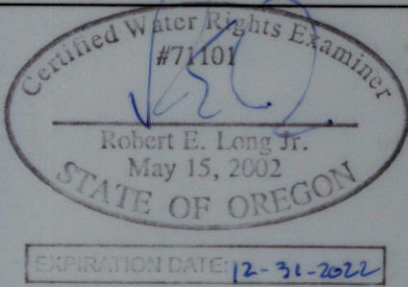


CwM-H2O
 Complete Water Management

1319 SE MLK, Jr. Blvd, Suite 204
 Portland, Oregon 97214
 (503) 954-1326



This map is not intended to provide
 legal dimensions or locations of
 property ownership lines.

1	DATE	AUTH	DRAFT
No.	Date	By	Revisions

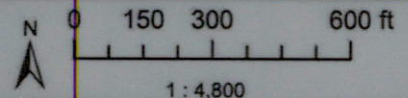

Proj#: 2123001
 Oregon Flowers CBUs
 Oregon Flowers
 20727 Highway 99E NE
 Aurora, OR, 97002

Claim of Beneficial Use Application Map
App. No. S-84720, Perm. No. S-53910
T2S, R1W, SENE and SWNE Section 11 W.M.

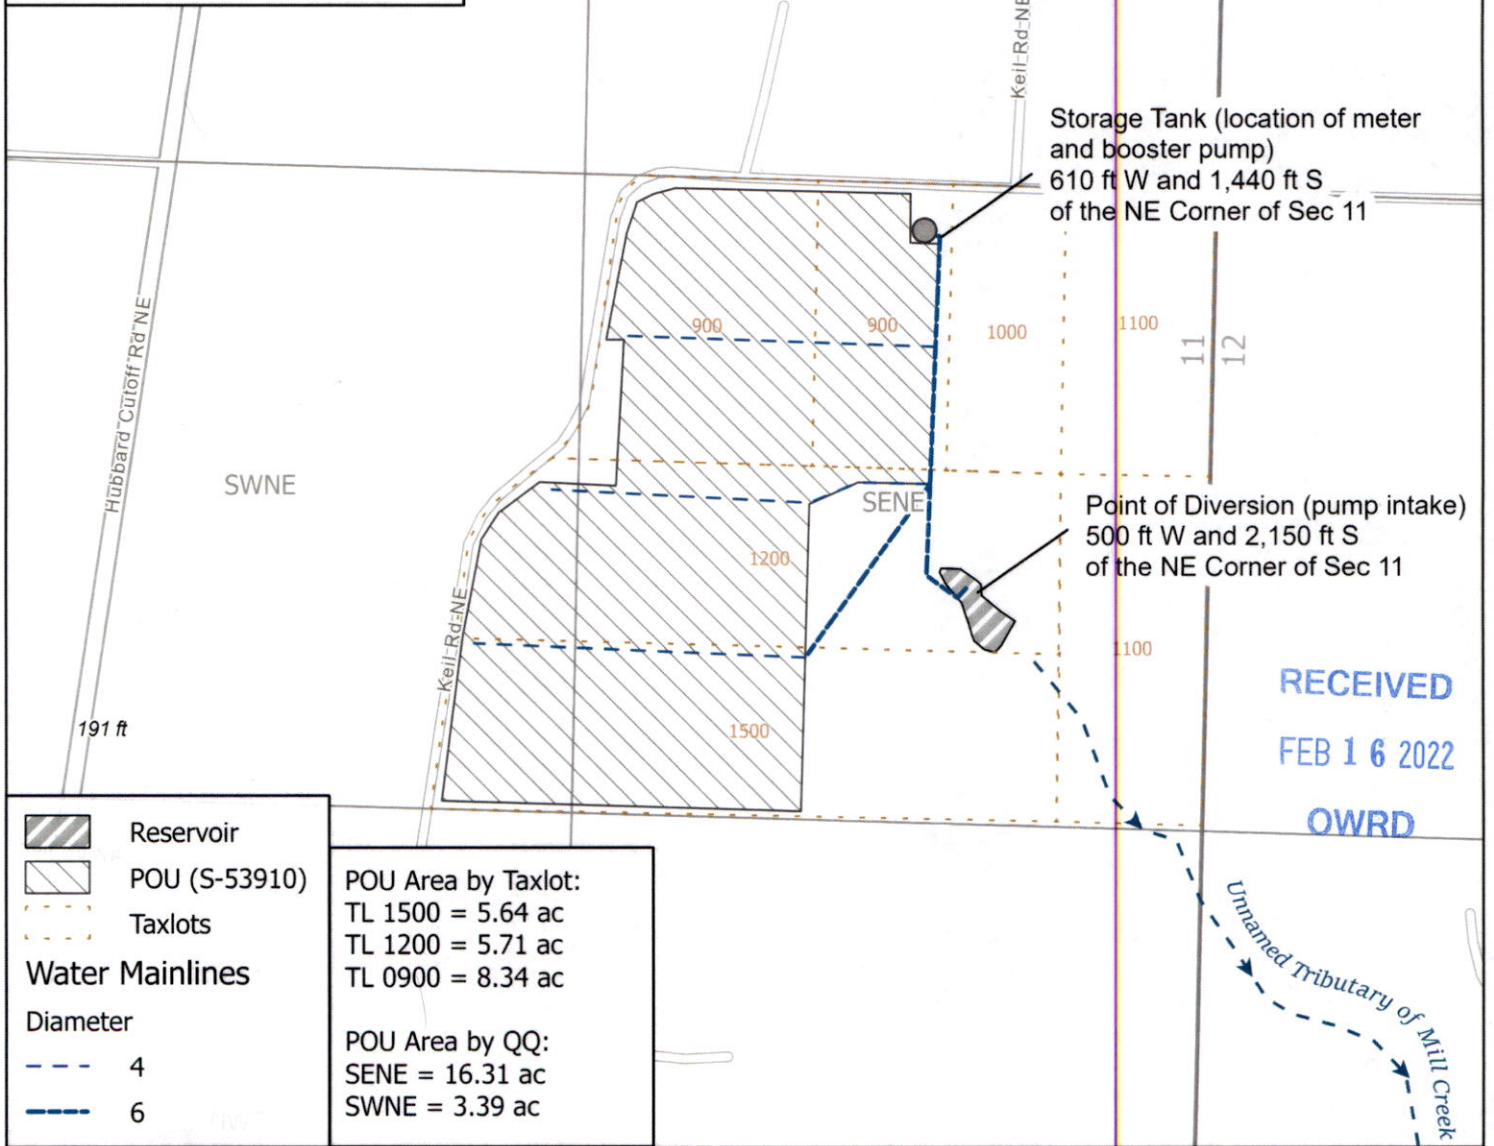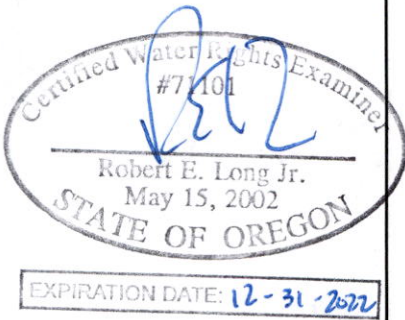

CwM-H2O
Complete Water Management

1319 SE MLK, Jr. Blvd, Suite 204
Portland, Oregon 97214
(503) 954-1326

This map is not intended to provide
legal dimensions or locations of
property ownership lines.

1	DATE	AUTH	DRAFT
No.	Date	By	Revisions



0 150 300 600 ft
1 : 4,800

Proj#: 2123001
Oregon Flowers CBUs
 Oregon Flowers
 20727 Highway 99E NE
 Aurora, OR, 97002