

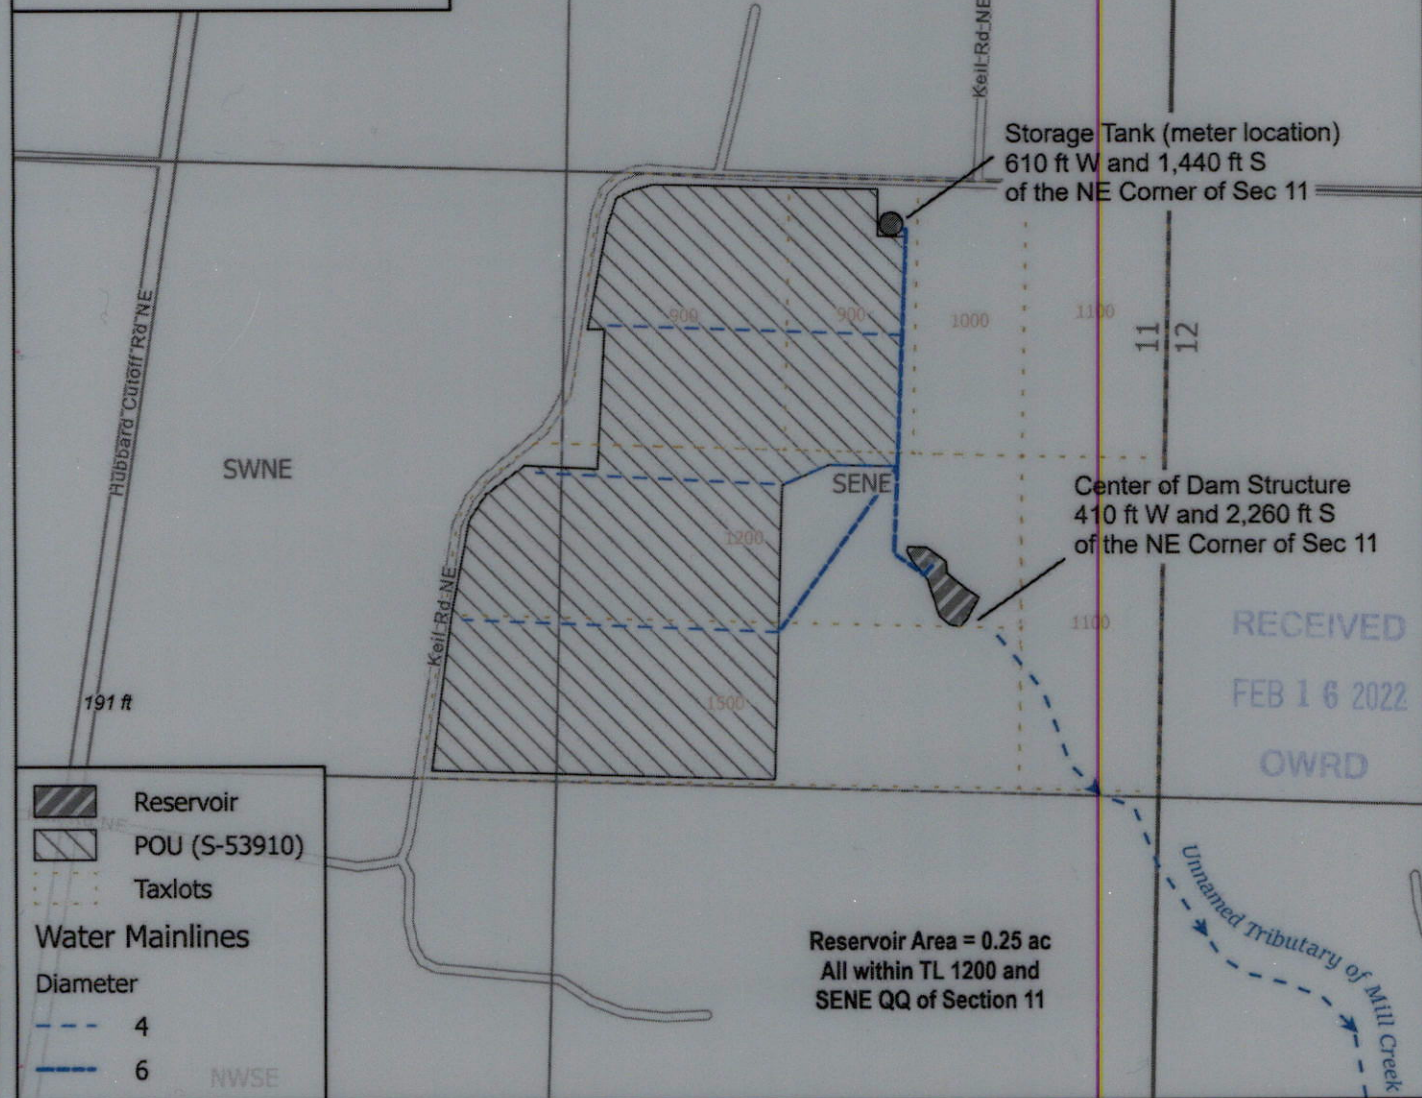


Claim of Beneficial Use Application Map
App. No. R-84721, Perm. No. R-13571
T2S, R1W, Section 11 W.M.

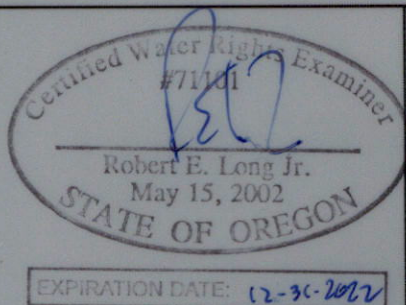


RECEIVED
 FEB 16 2022
 OWRD

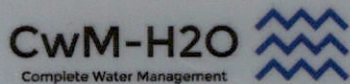

1319 SE MLK, Jr. Blvd, Suite 204
 Portland, Oregon 97214
 (503) 954-1326


This map is not intended to provide legal dimensions or locations of property ownership lines.

1	DATE	AUTH	DRAFT
No.	Date	By	Revisions

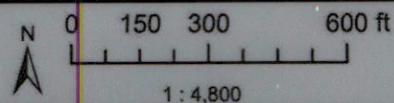

Proj#: 2123001
 Oregon Flowers CBUs
 Oregon Flowers
 20727 Highway 99E NE
 Aurora, OR, 97002

Claim of Beneficial Use Application Map
App. No. R-84721, Perm. No. R-13571
T2S, R1W, Section 11 W.M.

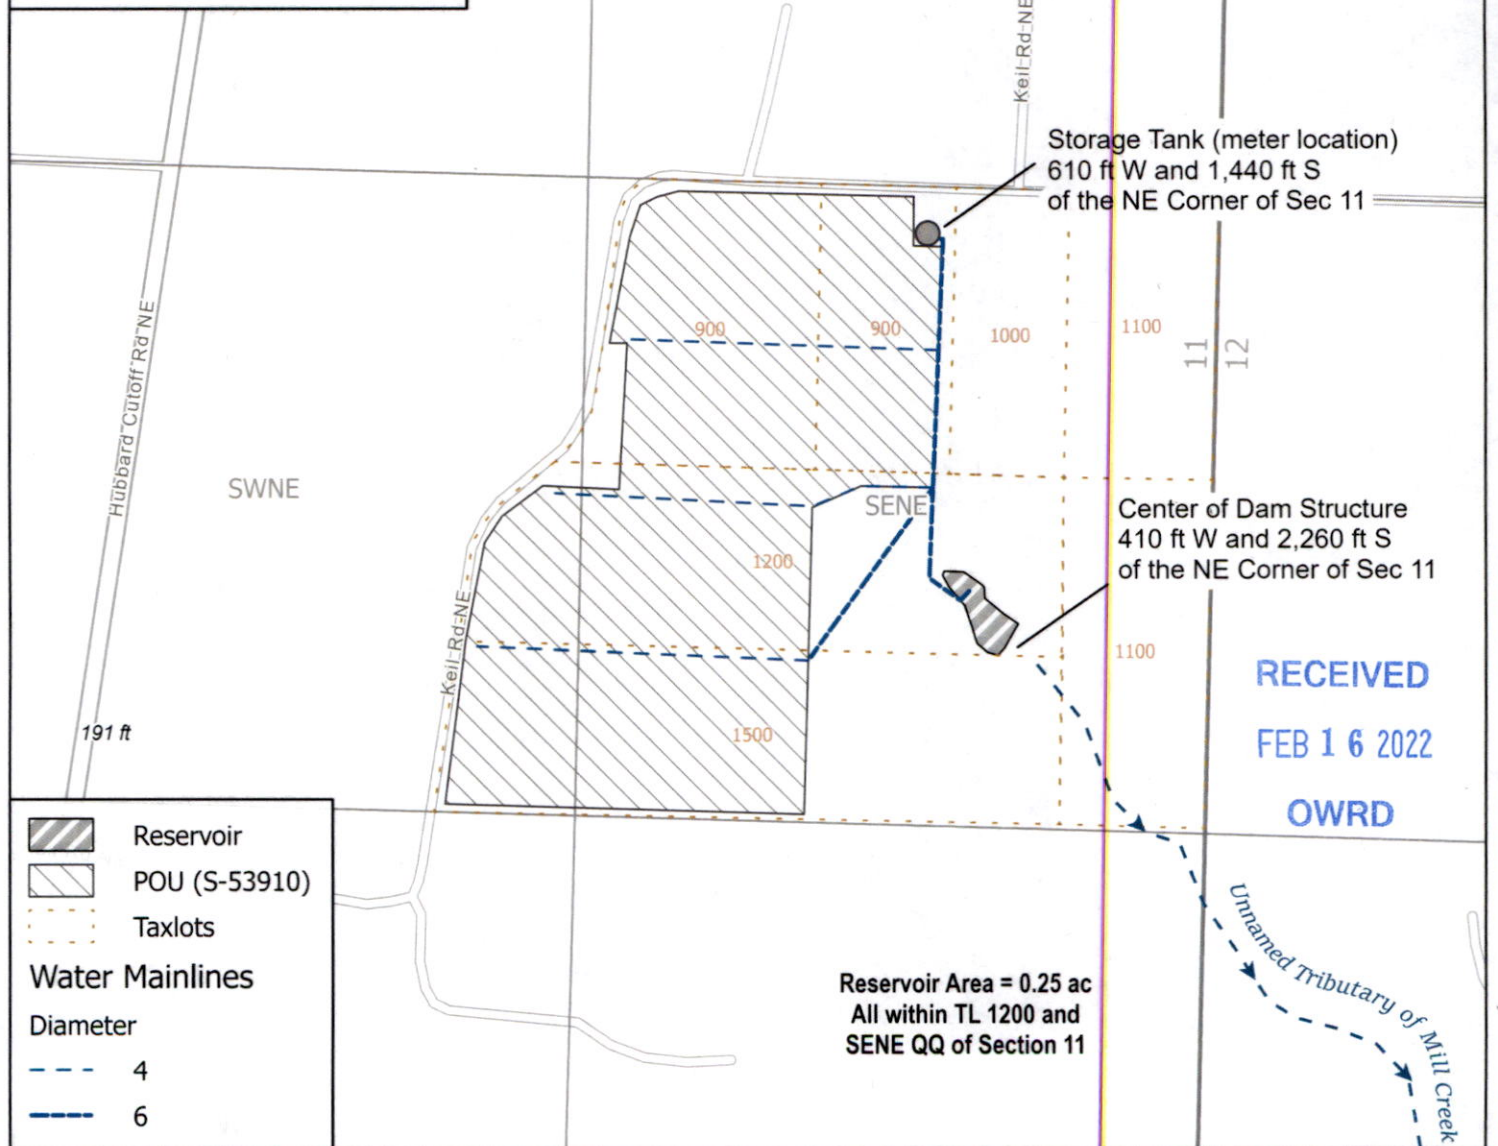


RECEIVED
FEB 16 2022
OWRD

CwM-H2O
 Complete Water Management

1319 SE MLK, Jr. Blvd, Suite 204
 Portland, Oregon 97214
 (503) 954-1326

This map is not intended to provide
 legal dimensions or locations of
 property ownership lines.

No.	Date	By	Revisions
1	DATE	AUTH	DRAFT

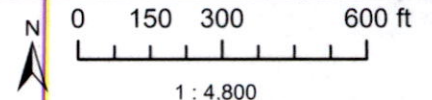

Proj#: 2123001
Oregon Flowers CBUs
 Oregon Flowers
 20727 Highway 99E NE
 Aurora, OR, 97002