


Great Western Farms and Ranches LLC



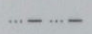


Claim Of Beneficial Use Map for G-15134

T 40 S, R 9 E,
Sec 1 & 2

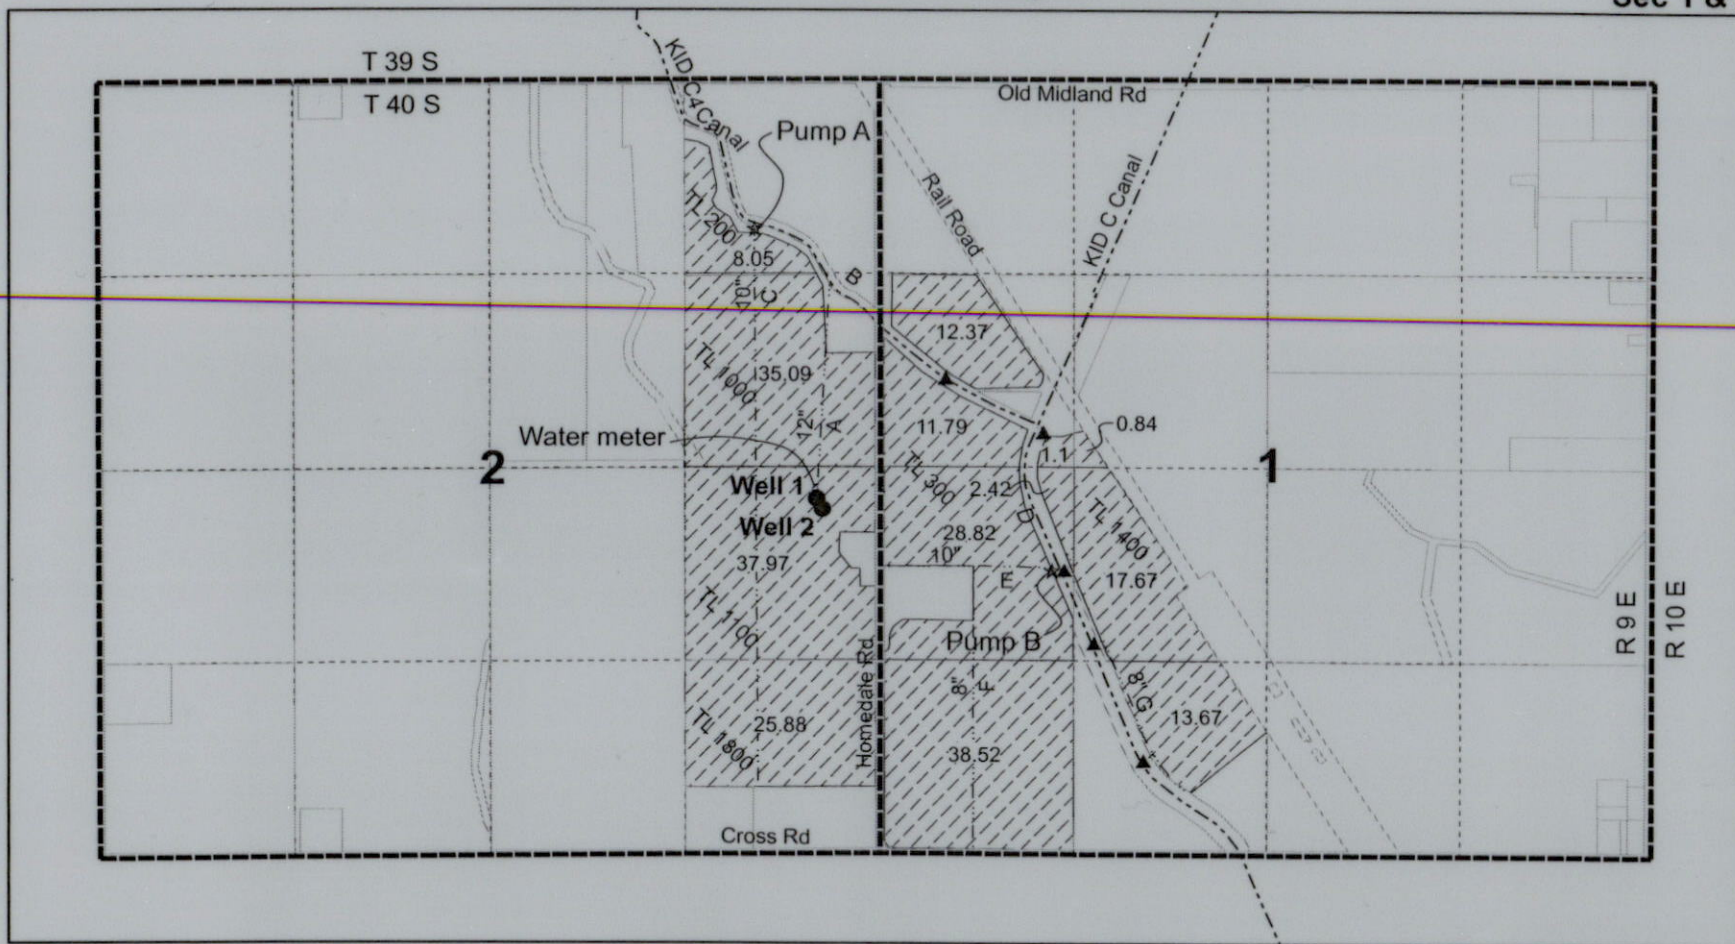

RECEIVED
MAR 11 2022
OWRD

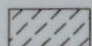Legend


-  Supplemental irrigation of 234.19 ac
-  Wells
-  Pipelines gravity and pressure
-  Pump stations
-  Canal gate turn out 18"

1 inch = 1,320 feet



Well #1 located 213.8 ft South & 439.4 ft West
Well #2 located 282.2 ft South & 400.8 ft West
both from the E 1/4 Cor Sec. 2, T 40 S, R 9 E, WM
both located in the NESE of Sec 2

Pipe/Ditch on map	Gravity/Pressure	Size	Type	Capacity
A	Gravity	12"	PVC	4.9 cfs
B	Open ditch		earth	45.7 cfs
C	Pressure	10"	PVC	2.74 cfs
D	Open ditch		earth	172 cfs
E	Pressure	10"	PVC	2.74 cfs
F	Pressure	8"	PVC	1.73 cfs
G	Gravity	8"	PVC	1.73 cfs

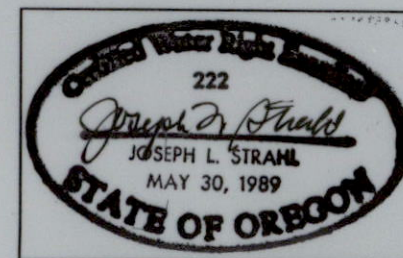

Expires 06/30/2022

Note: This map is not intended to provide legal dimensions or locations of property ownership lines.