
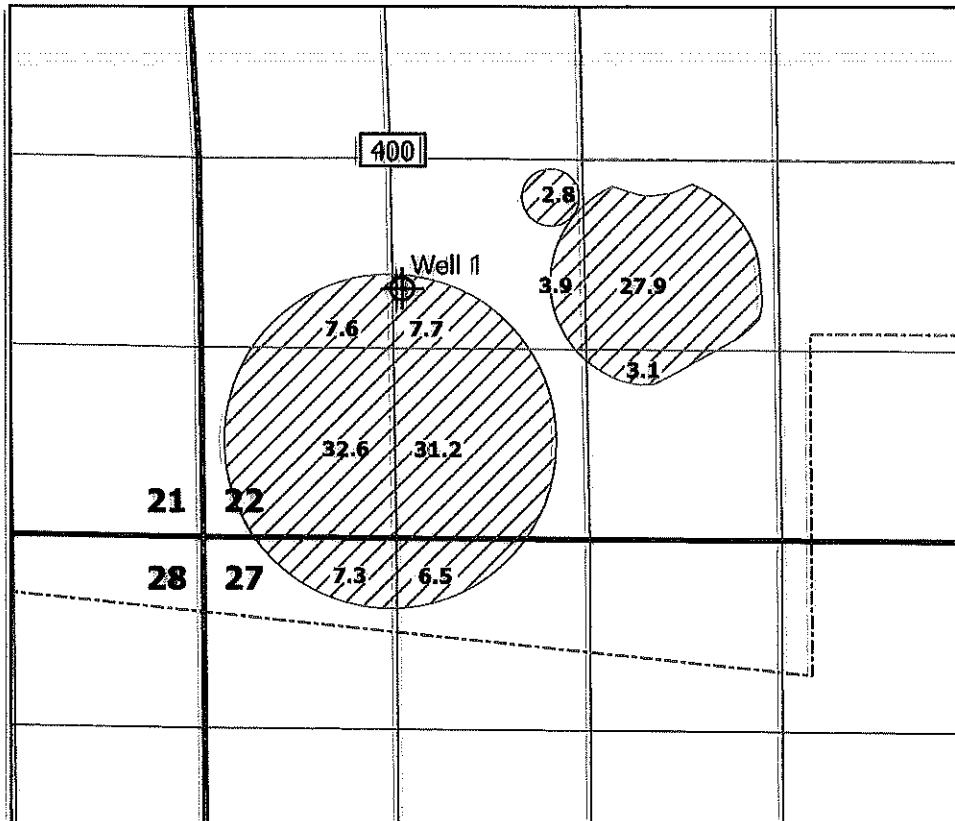


T 19S R 44E WM

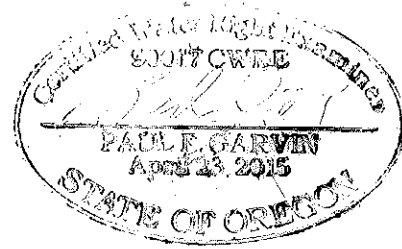

LEGEND

Place of Use

Malheur County Taxlot Boundary 400

**Garvin
HydroGeo
LLC**

**Claim of Beneficial Use Map
Transfer T-13038
Malheur County, OR**

Prepared on behalf of Jonathon and Lacey Blake

1 inch = 1,320 feet



This map is not intended to provide legal dimensions or locations of property ownership lines.

Well 1: 3,400' South and 1,540' East from the NW Corner of Section 22

Flowmeter is located within a 10 foot radius of Well 1

Drawn by: Paul F. Garvin, RG, CWRE
Date: 10/18/21