

Carlton reservoir options

Legend

??Abbott Claim

Feature 1

Feature 2


<= Dividing line between sections

Section 26

Section 25

NE Bayliss Rd Abbott Claim

Reservoir on this application =>

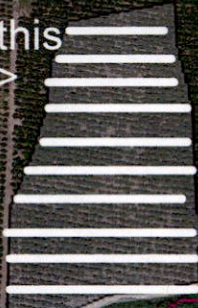

x
Point of diversion
is 2,500' south
and 802' east of
the vector of
Section 25

3S4W sections 25 & 26
Tax lot: R3425 00600

NE Mineral Springs Rd

RECEIVED
OCT 4 2022
OWRD



Carlton reservoir options

Legend

- ? ?Abbott Claim
- Feature 1
- Feature 2

<= Dividing line between sections


Section 26

Section 25

NE Bayliss Rd

NE Bayliss Rd Abbott Claim

Reservoir on this application =>

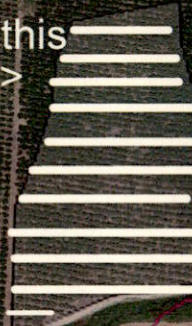

x Point of diversion (pump location)

3S4W sections 25 & 26

Tax lot: R3425 00600

NE Mineral Springs Rd

Google Earth

1" = 333'

1000 ft

