


CLAIM OF BENEFICIAL USE MAP FOR TRANSFER T-8698
FOR AN ADDITIONAL POINT OF APPROPRIATION
IN THE NAME OF LAURIE ROSS
T2S, R24E, W.M. MORROW COUNTY

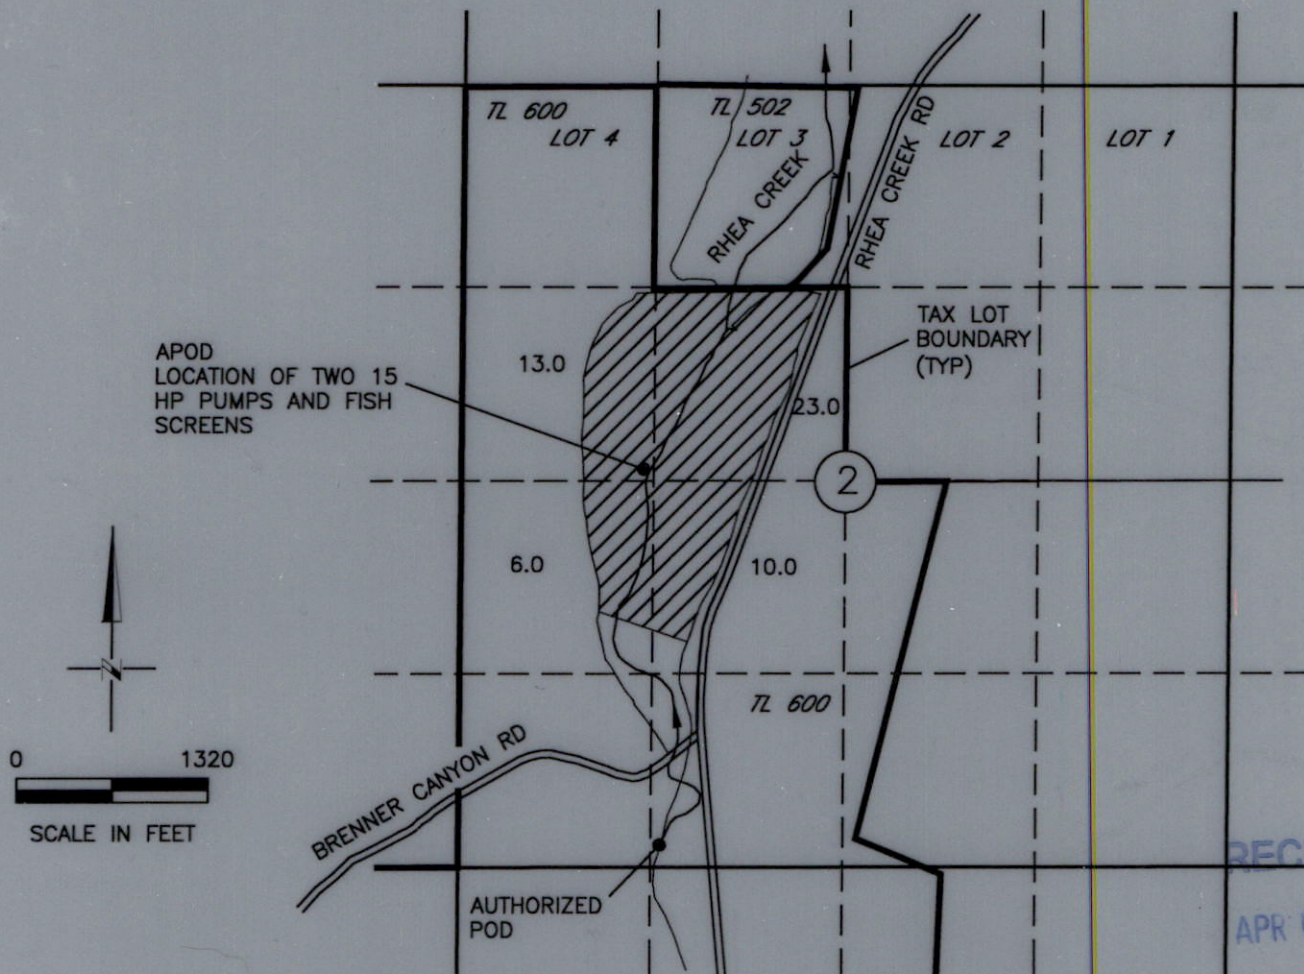

LEGEND




IRRIGATED AREA

LOCATION OF PODs

APOD (BEING CLAIMED WITH THIS COBU)
LOCATED 2660' S AND 1290' E FROM
THE NW CORNER OF SEC 2

AUTHORIZED POD (FROM TRANSER APPLICATION MAP)
1330' EAST AND 150' NORTH OF THE SW CORNER
OF SEC 2

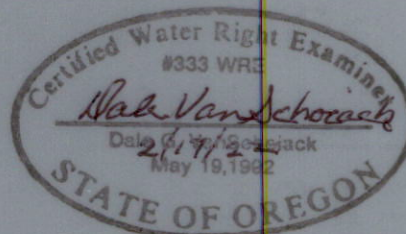

Renews 6/30/22

RECEIVED
APR 04 2022
OWRD

NOTE: THE PURPOSE OF THIS MAP IS TO IDENTIFY THE APPROXIMATE LOCATION OF THE WATER RIGHT. IT IS NOT INTENDED TO PROVIDE INFORMATION RELATIVE TO THE LOCATION OF PROPERTY OWNERSHIP BOUNDARY LINES. PIPELINE LOCATIONS AND SIZES WERE PROVIDED BY THE WATER USER AND HAVE NOT BEEN VERIFIED.

DGV Consulting, PLLC
PHONE (509) 627-8717
dalevconsulting@gmail.com
Date: January 27, 2022