


T. 11 S., R. 24 E., W. M.



MAY 12 1997
WATER RESOURCES DEPT.
S. L. 11 S. 24 E. 11 W.

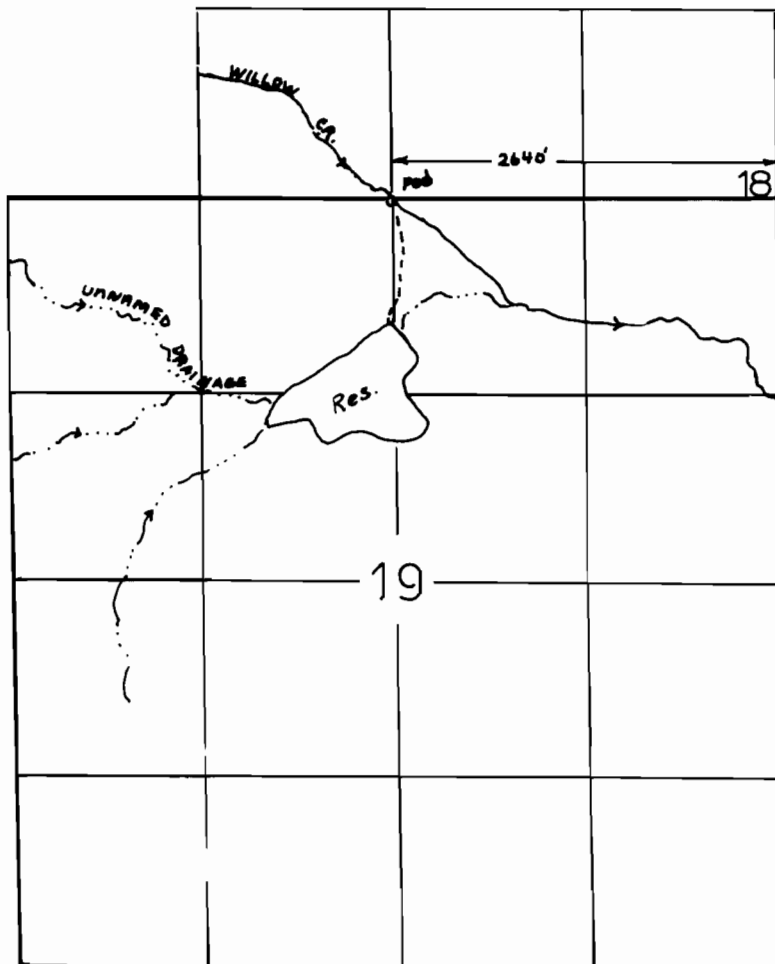

1" = 1320'


FINAL PROOF SURVEY
UNDER

Application No. R-66016. Permit No. R-2397.....
IN NAME OF

.....FRED HARUDA.....

Surveyed Sept. 22 1994, by J. MILLER.....

T. 11 S., R. 24 E., W. M.

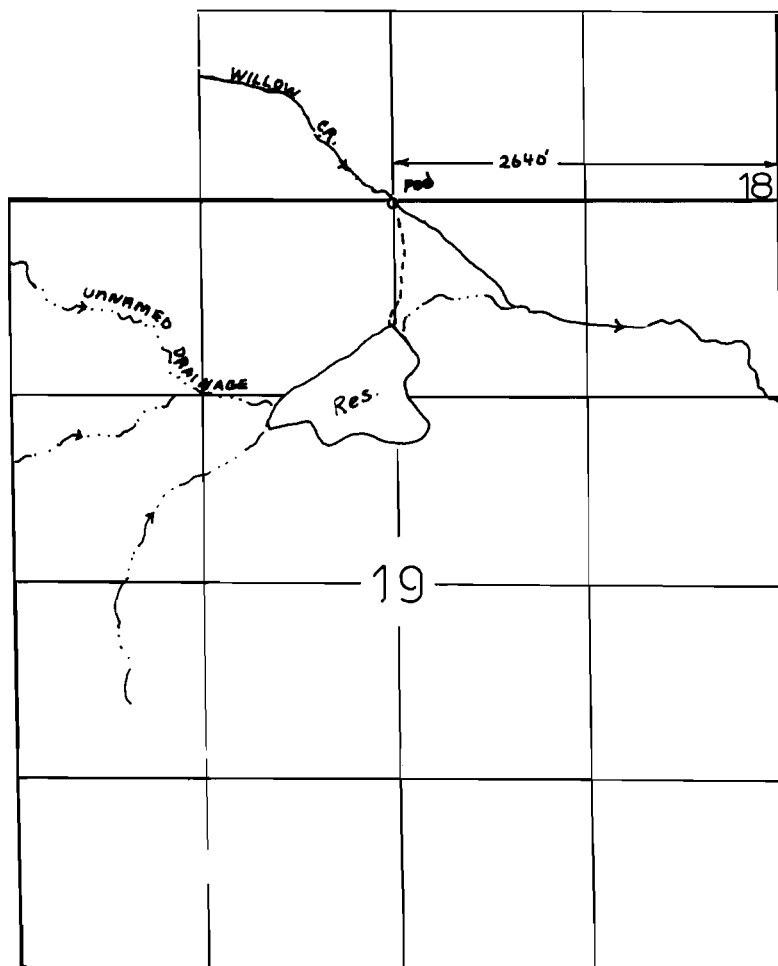

1" = 1320'

FINAL PROOF SURVEY
UNDER

Application No. R-66016. Permit No. R-2397.....
IN NAME OF

.....FRED HARUDA.....

Surveyed Sept. 22, 1994, by J. MILLER.....