


T. 32 S., R. 4 W., W. M.

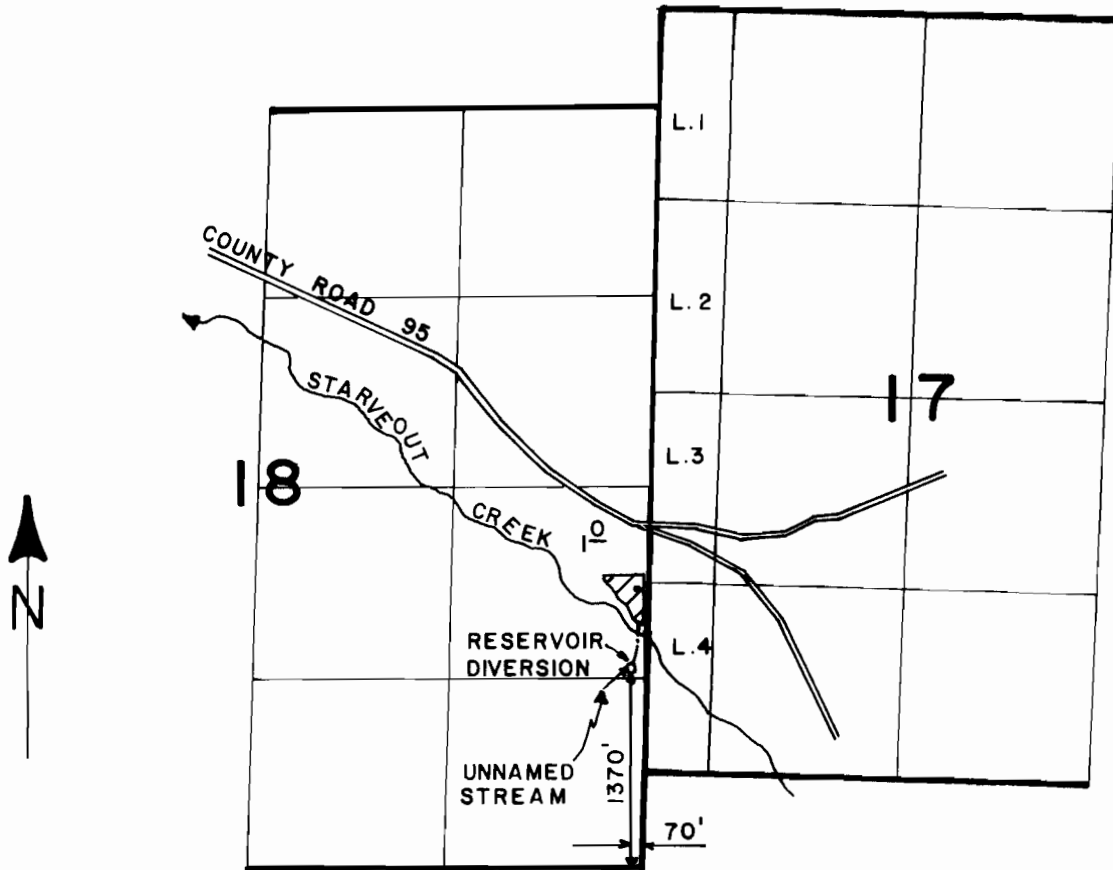

SCALE: 4" = 1 MILE

**FINAL PROOF SURVEY**  
UNDER

R- 66053                      R-9094  
Application No. 66054      Permit No. 48053  
IN NAME OF

**PATRICK MICHAEL LEONARD AND CHRISTINE WESTPHAL**

Surveyed JULY 14, 1988, by J. M. SCHMORDE