


T. 32 S., R. 4 W., W.M.

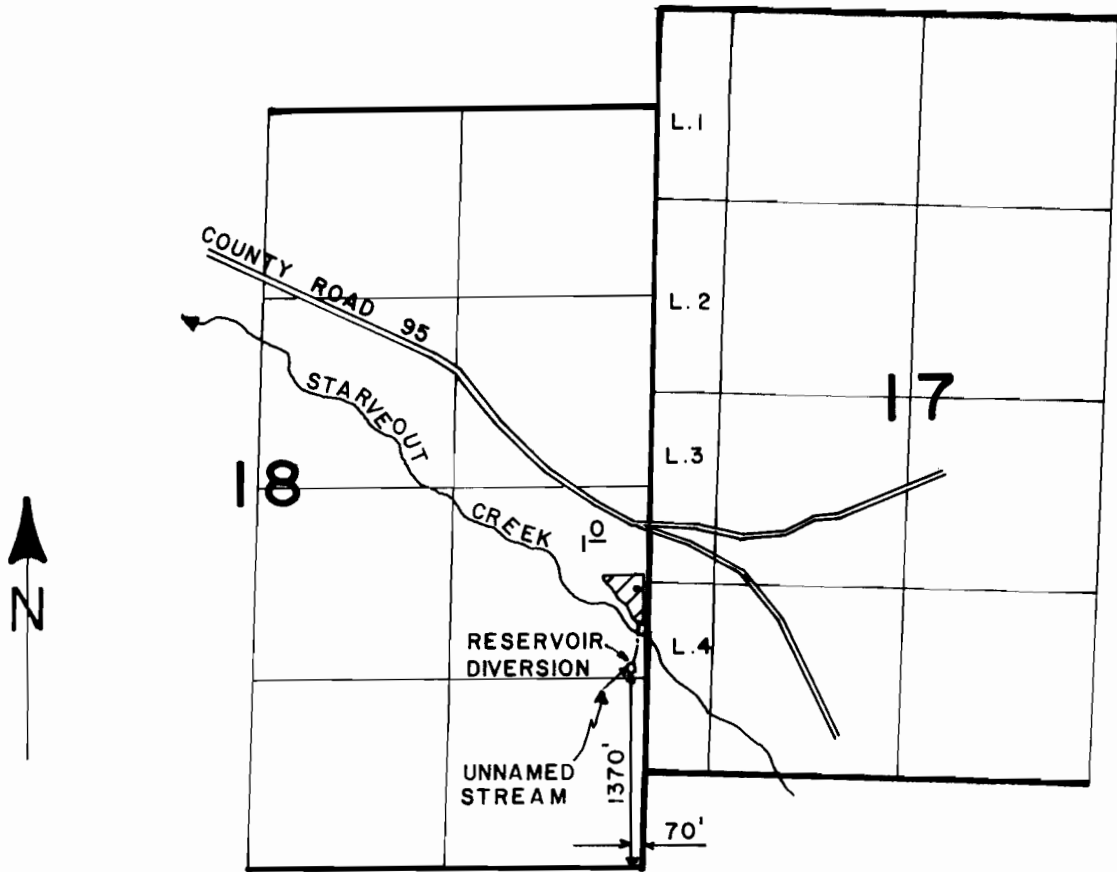

SCALE: 4" = 1 MILE

FINAL PROOF SURVEY
UNDER

R- 66053 R-9094
Application No. 66054 Permit No. 48053
IN NAME OF

PATRICK MICHAEL LEONARD AND CHRISTINE WESTPHAL

Surveyed JULY 14, 1988, by J. M. SCHMORDE