

UNITED STATES
DEPARTMENT OF THE INTERIOR
BUREAU OF LAND MANAGEMENT

RECEIVED


JAN 4 1985

SECTION: 24
NW 1/4 NW 1/4

Oregon State Water Filings

WATER RESOURCES DEPT
SALEM, OREGON

TOWNSHIP 16 S, RANGE 22 E, W. M.

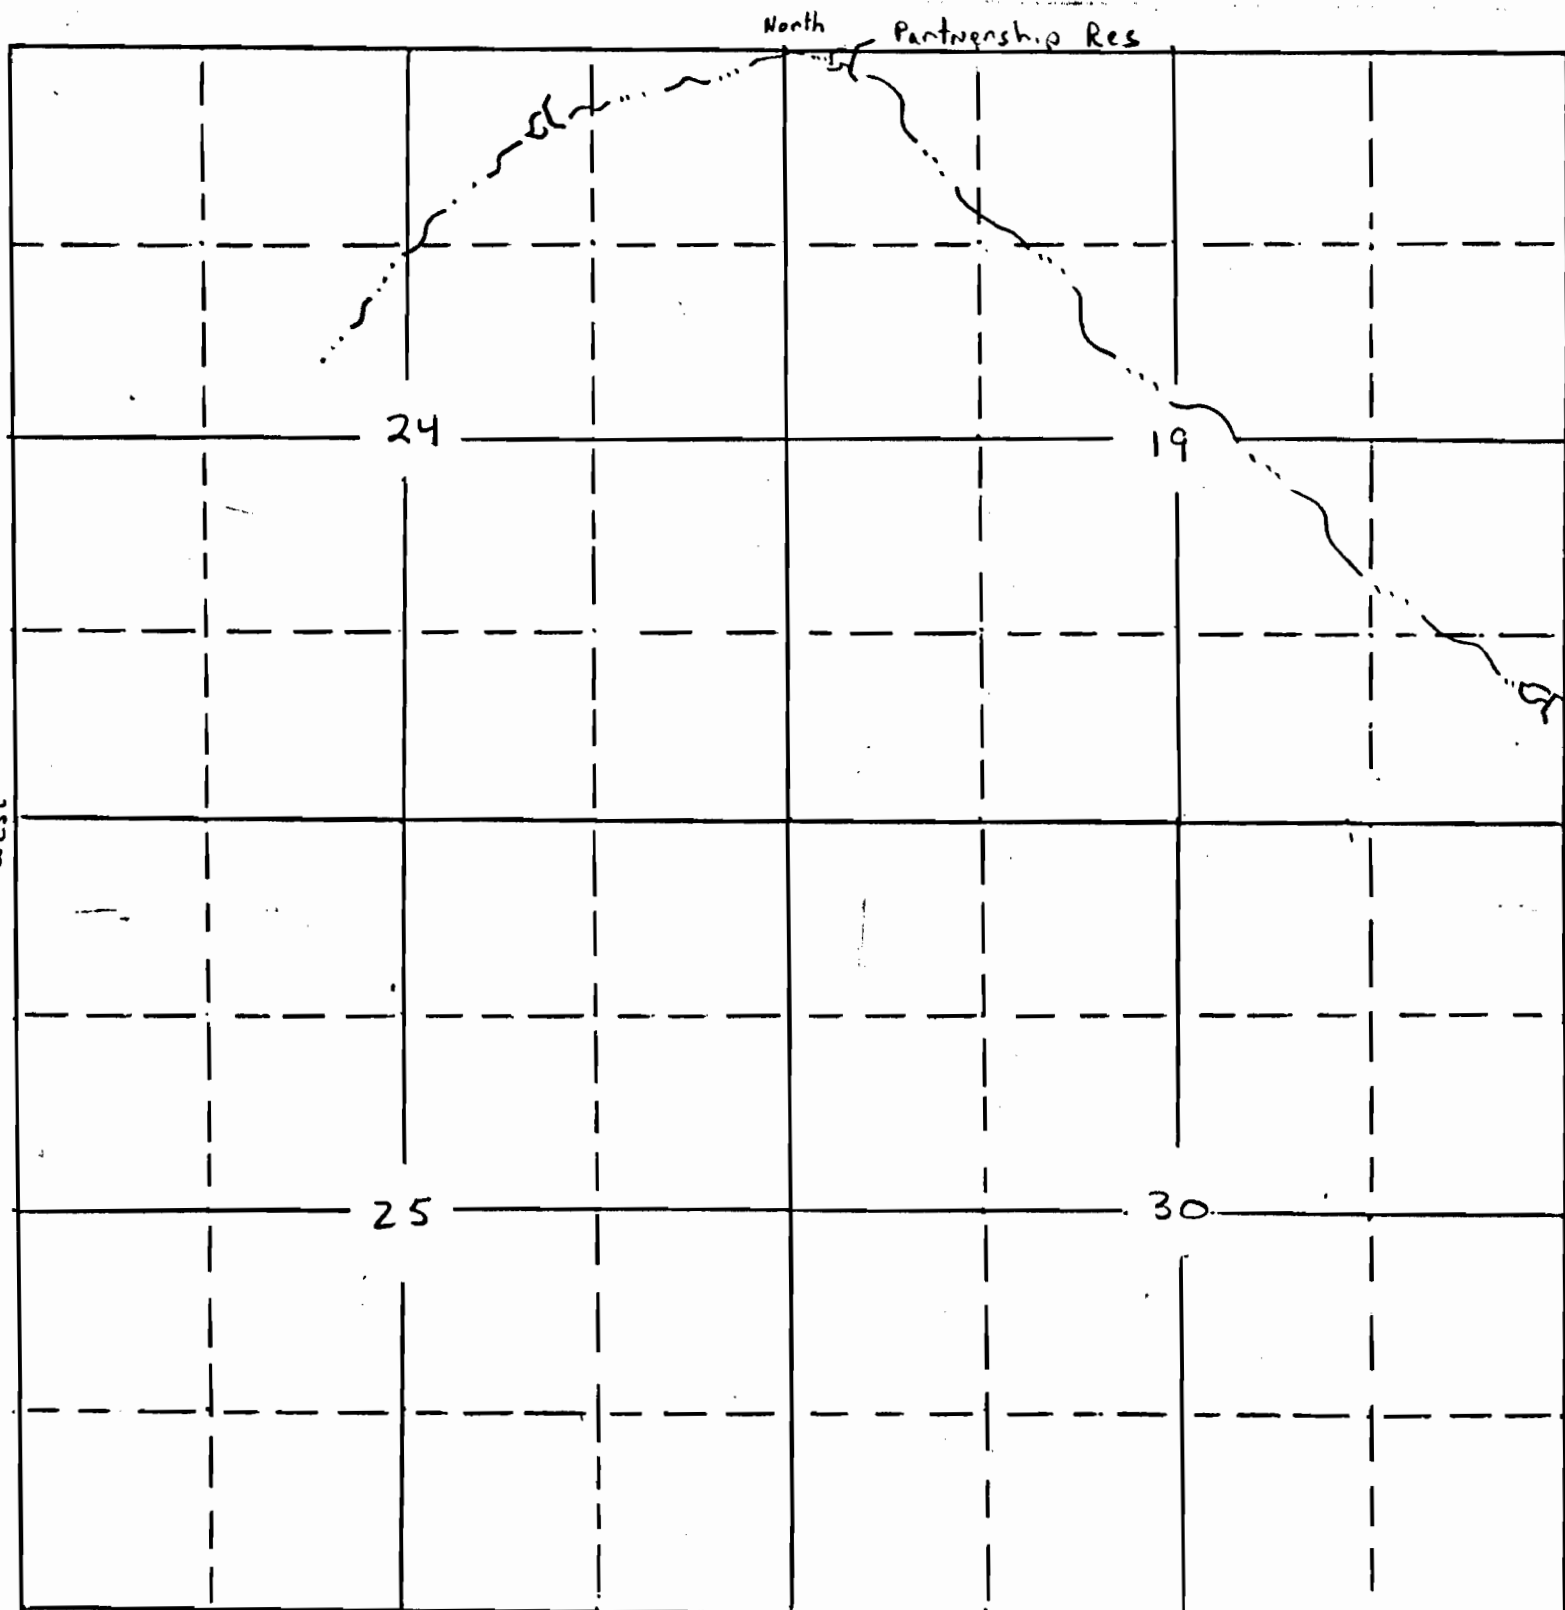

South

APPLICATION No.

R66060

PERMIT No.

R11803