

UNITED STATES
DEPARTMENT OF THE INTERIOR
BUREAU OF LAND MANAGEMENT

SECTION 25


Oregon State Water Filings

NE 1/4 NW 1/4

TOWNSHIP 24S, RANGE 36E, W. M.

North

Island 5243

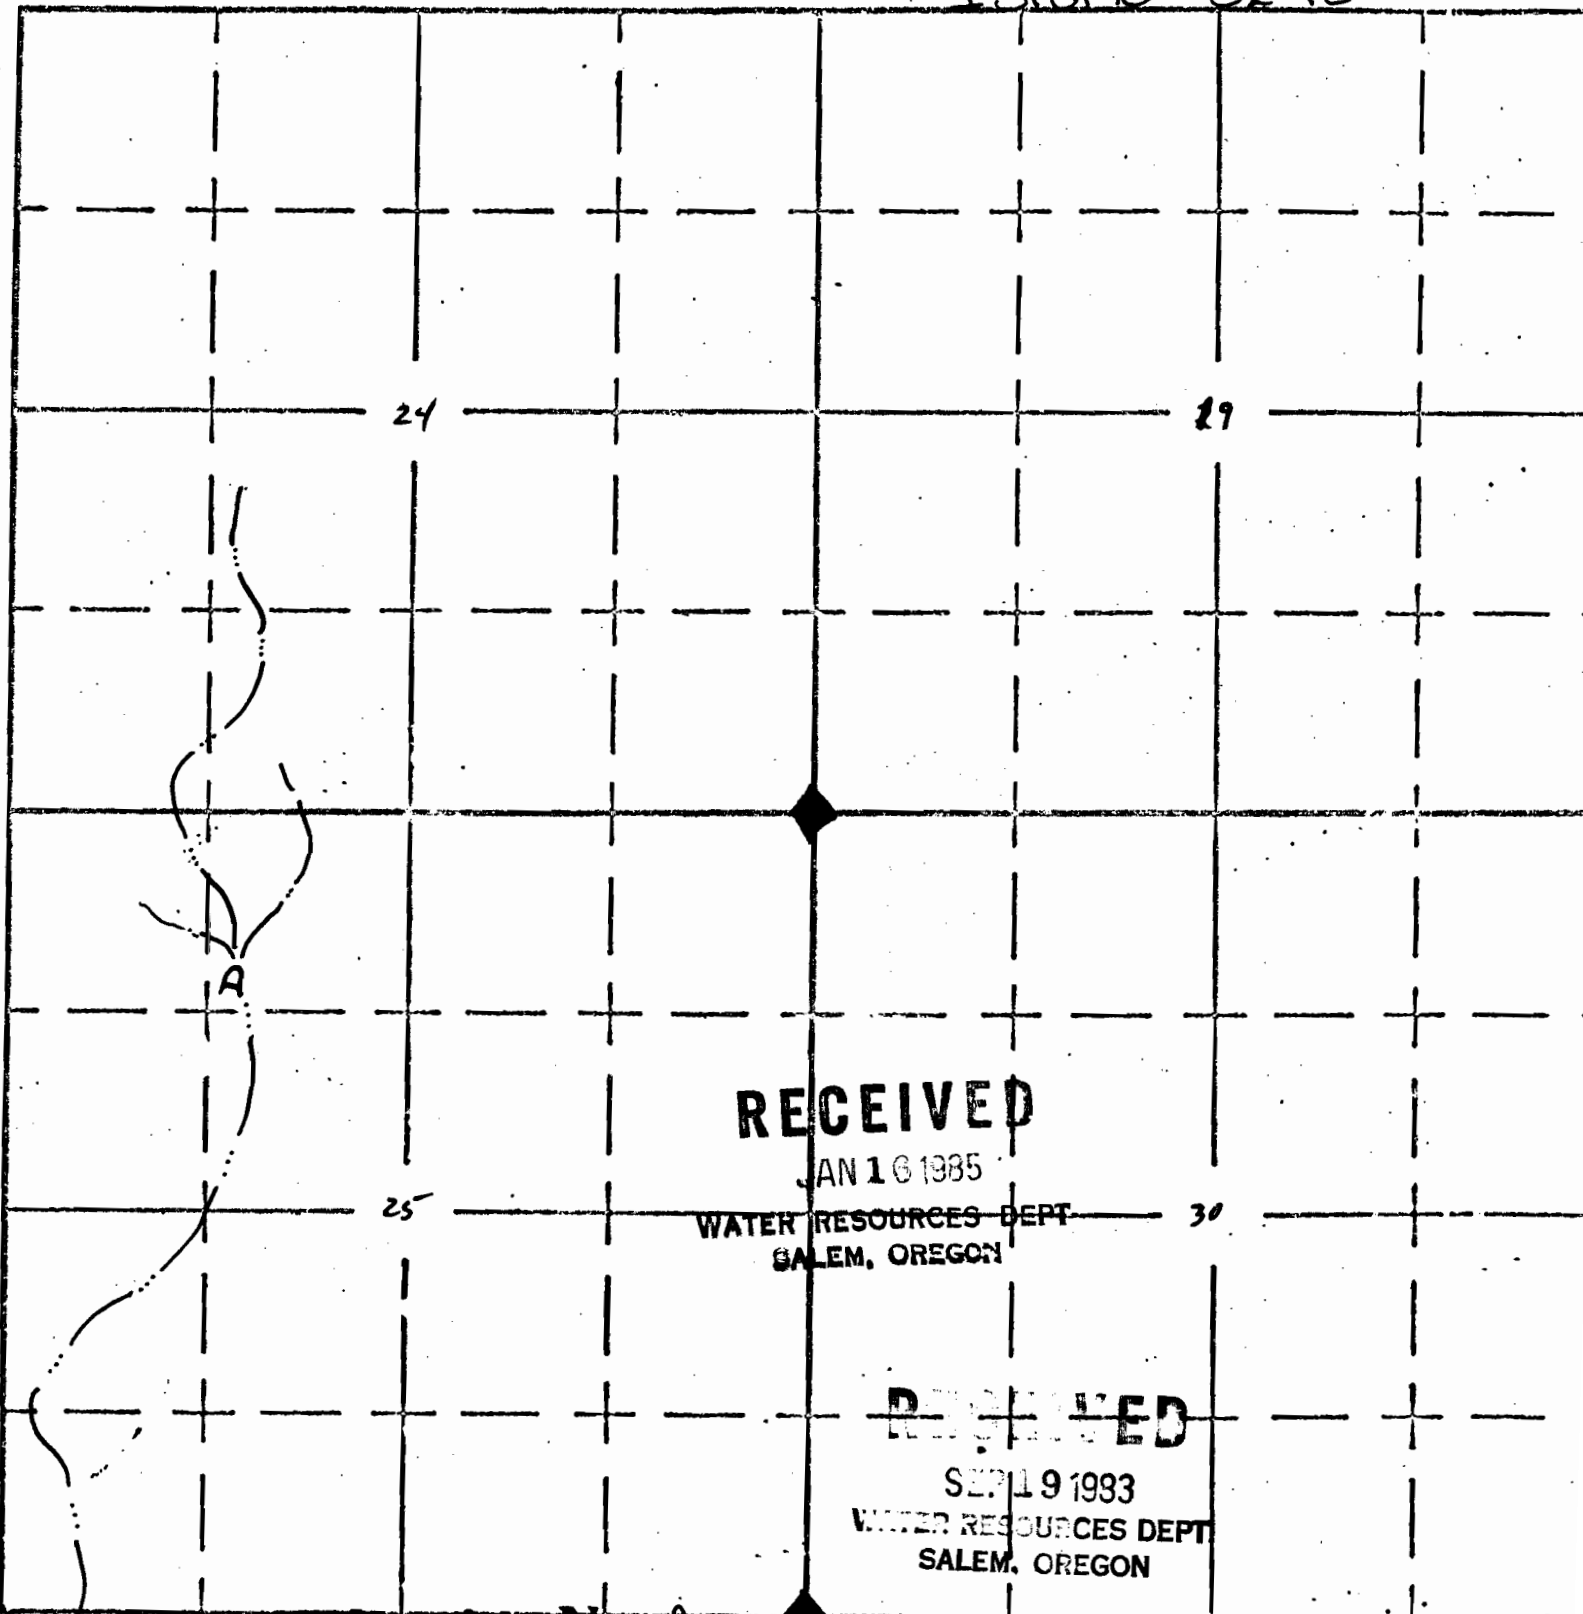

Application No. R-664-76
Permit No. R11129

APPLICATION No: