


# FINAL PROOF SURVEY MAP IN THE NAME OF LYNN AND ROSE CANNON

APPLICATION R - 75393  
S - 75394

PERMIT R - 12098  
53008

SECTION 13, TOWNSHIP 30 SOUTH, RANGE 15 WEST, W.M.

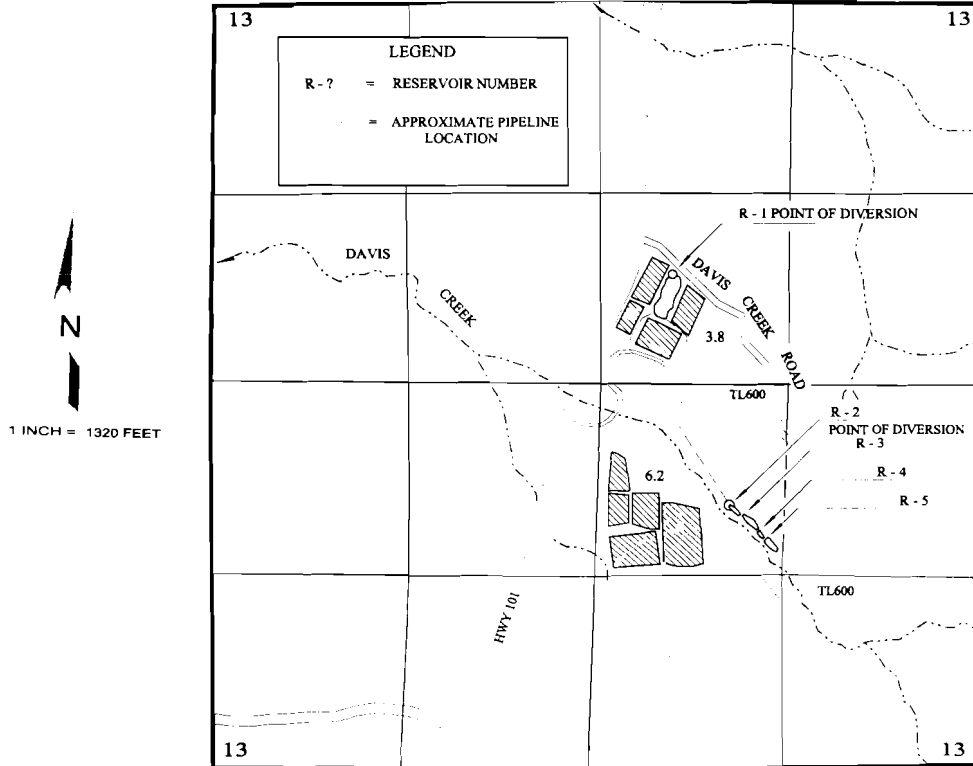

THE POINTS OF DIVERSION ARE LOCATED AS FOLLOWS:


RESERVOIR No.	NORTH	WEST	¼ ¼ SECTION
R - 1	3400 FEET	2050 FEET	SW¼ NE¼
R - 2	1800 FEET	1670 FEET	NW¼ SE¼
R - 3	1730 FEET	1580 FEET	NW¼ SE¼
R - 4	1620 FEET	1470 FEET	NW¼ SE¼
R - 5	1560 FEET	1420 FEET	NW¼ SE¼

ALL FROM THE SOUTHEAST CORNER OF SECTION 13 AND WITHIN SECTION 13,  
TOWNSHIP 30 SOUTH, RANGE 15 WEST, W.M.; COOS COUNTY.

**RECEIVED**

**SEP 20 2000**

**WATER RESOURCES DEPT.  
SALEM, OREGON**

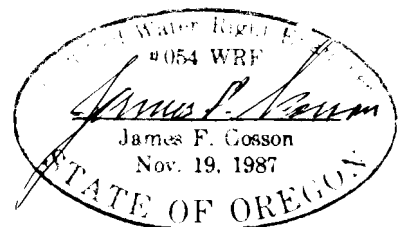

THE PURPOSE OF THIS MAP IS TO IDENTIFY THE LOCATION OF THE WATER RIGHT.  
IT IS NOT INTENDED TO PROVIDE INFORMATION RELATIVE TO THE LOCATION OF  
PROPERTY OWNERSHIP BOUNDARY LINES.