

UNITED STATES
DEPARTMENT OF THE INTERIOR
BUREAU OF LAND MANAGEMENT

RECEIVED

SEP 30 1983

WATER RESOURCES DEPT.
SALEM, OREGON

SECTION

4 SW 1/4 SW 1/4

Oregon State Water Filings

TOWNSHIP 20 S, RANGE 38 E, W. M.


Sec. 4

BOULDER PIT

North

Application No. R-67067

Permit No. R10301

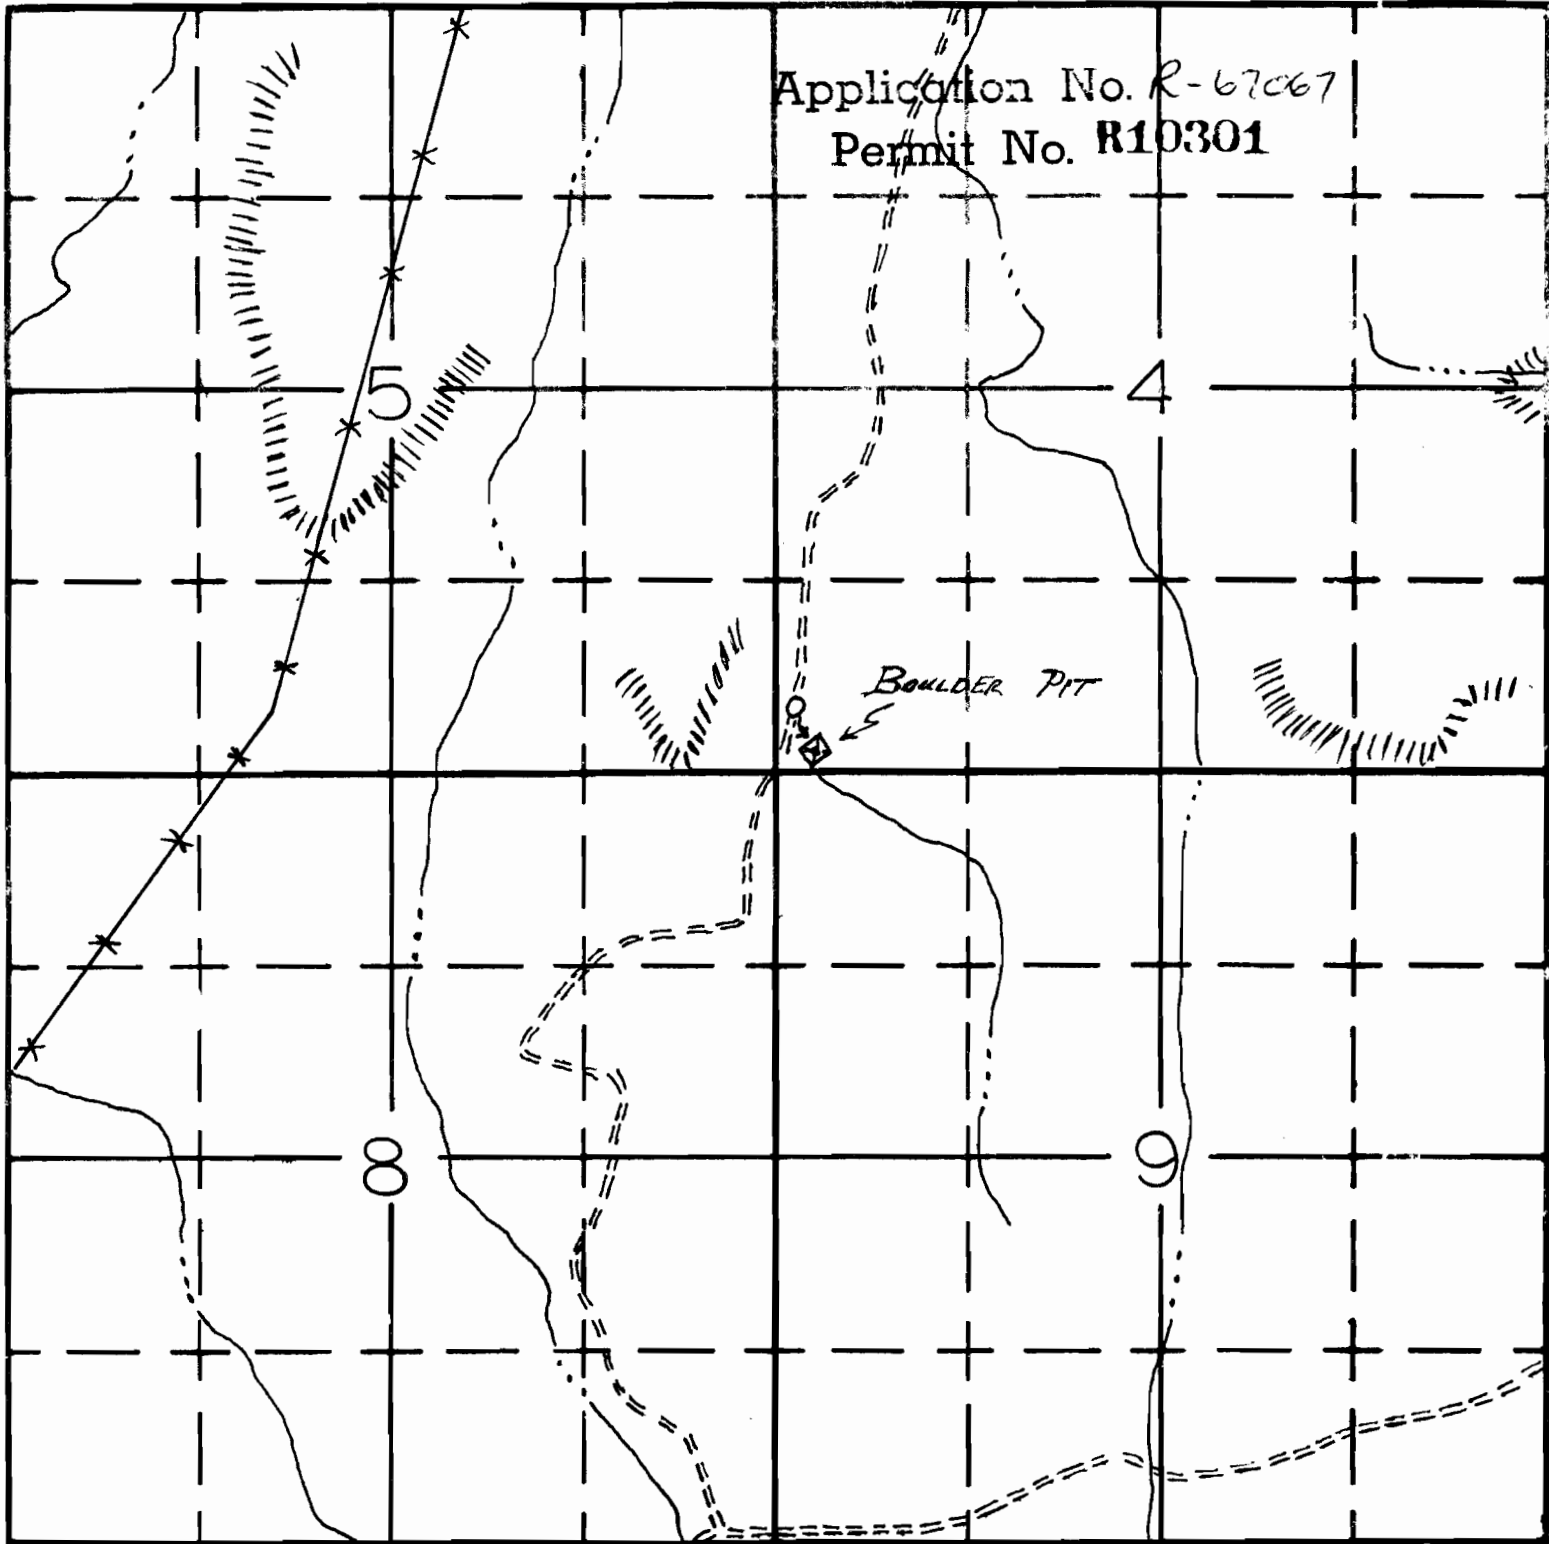

South

APPLICATION No.

PERMIT No.