

UNITED STATES
DEPARTMENT OF THE INTERIOR
BUREAU OF LAND MANAGEMENT

Section

7

Township

38S

Appl. No.

R67647

NENE

Range


24E

Permit No.

R 9506

Will. Mer.

Sheep Bell Waterhole 0975

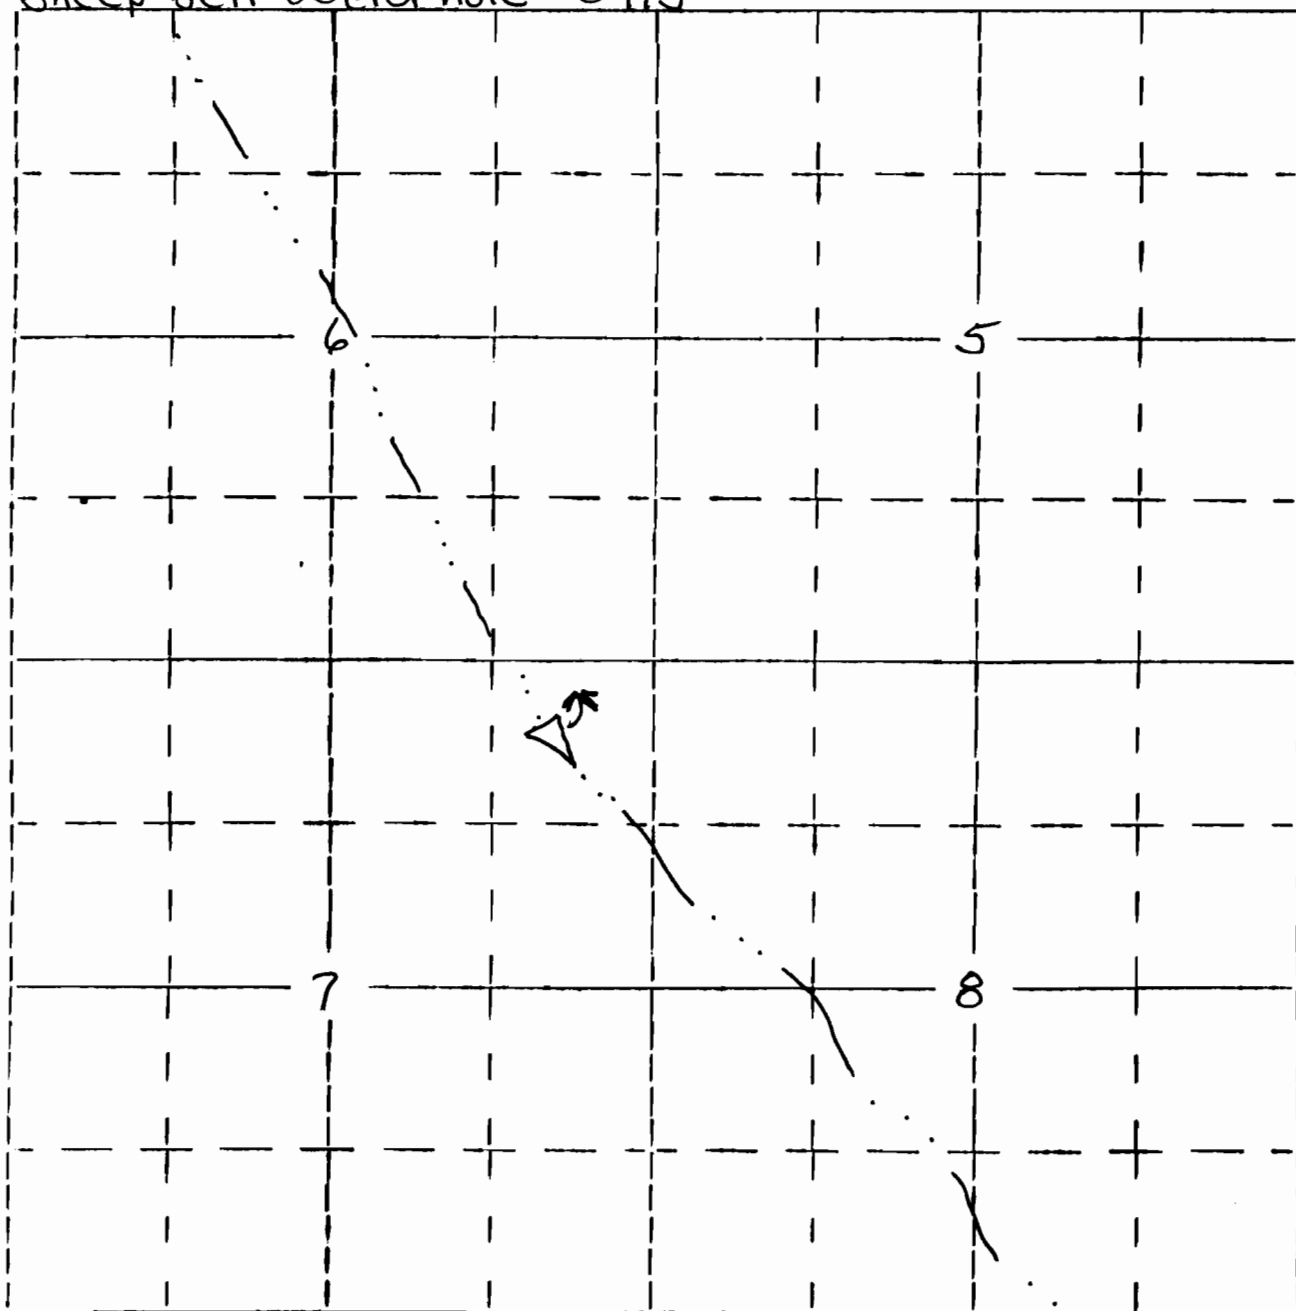

700'S 700' W of the NE corner of section 7.

1125273