

Form OR-010-7300-2
4/83

UNITED STATES
DEPARTMENT OF THE INTERIOR
BUREAU OF LAND MANAGEMENT

Section

16

Township 38 S


Appl. No. R67653

Range 28 E

Permit No. R-12769

Will. Mer.

RAINBOW #5520

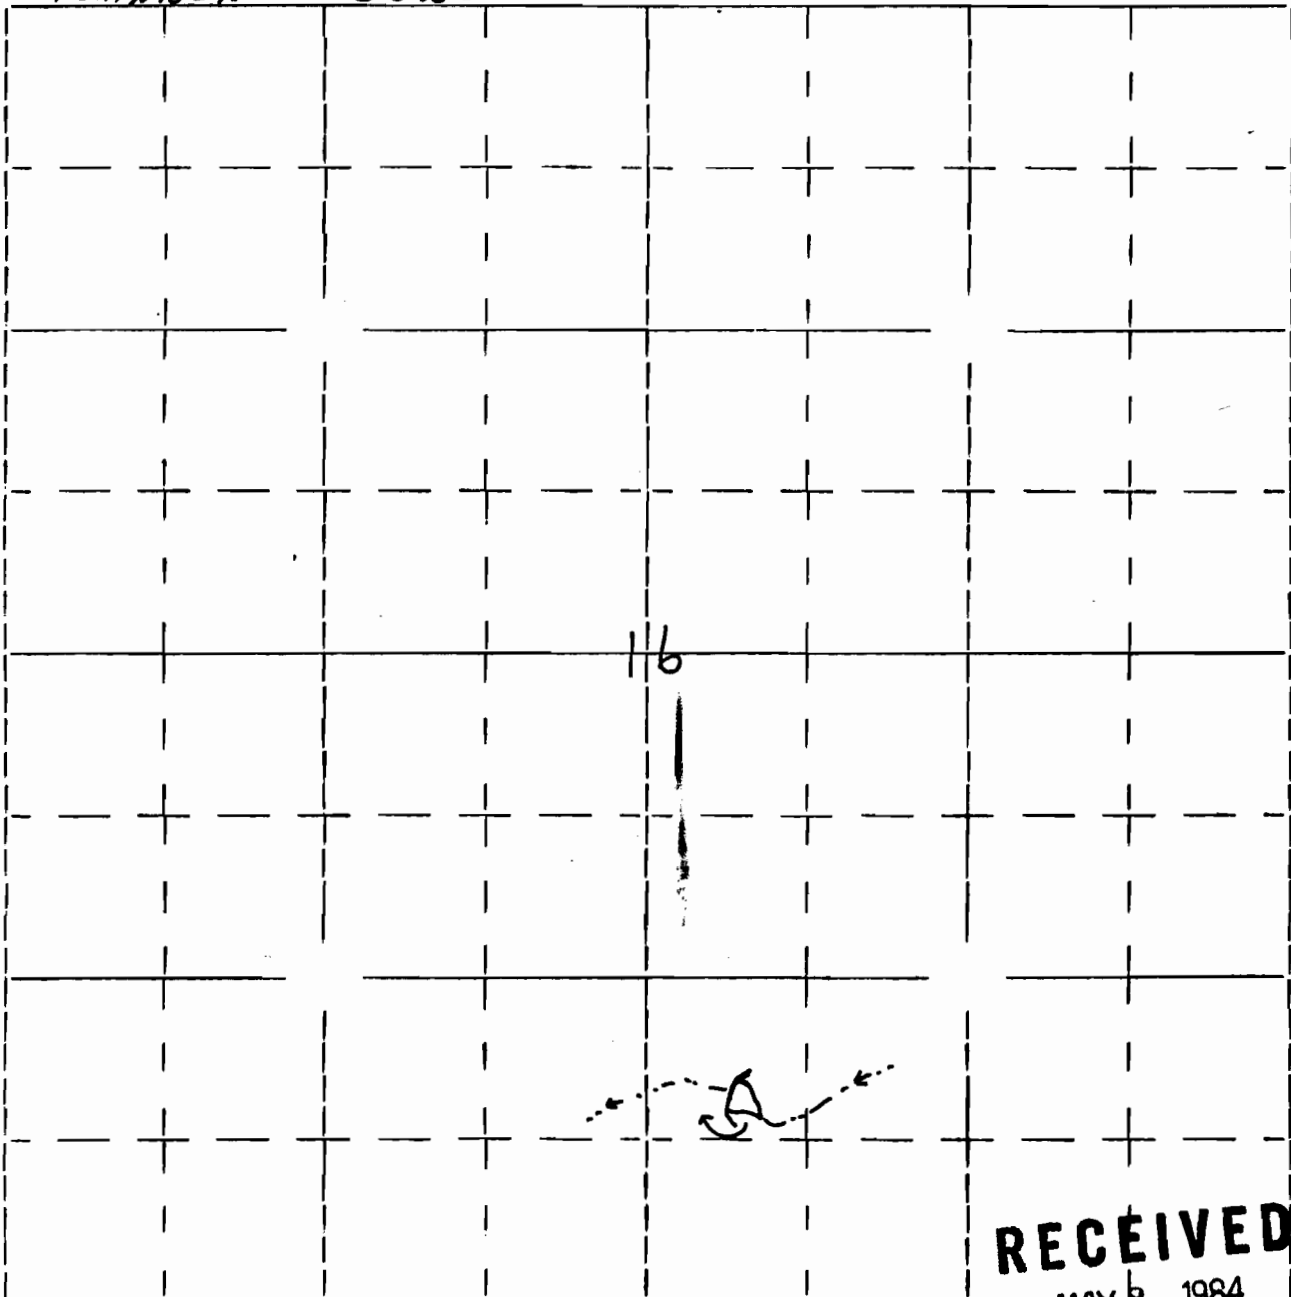

810' North and 2275' West
of the SE corner of Sec 16.

RECEIVED

MAY 8 1984

WATER RESOURCES DEPT
SALEM, OREGON