

Form AI-187
March 1961

UNITED STATES
DEPARTMENT OF THE INTERIOR
BUREAU OF LAND MANAGEMENT


SECTION

33 SWNE

Oregon State Water Filings

TOWNSHIP 28S, RANGE 38E, W. M.

North SEVENTY EIGHT

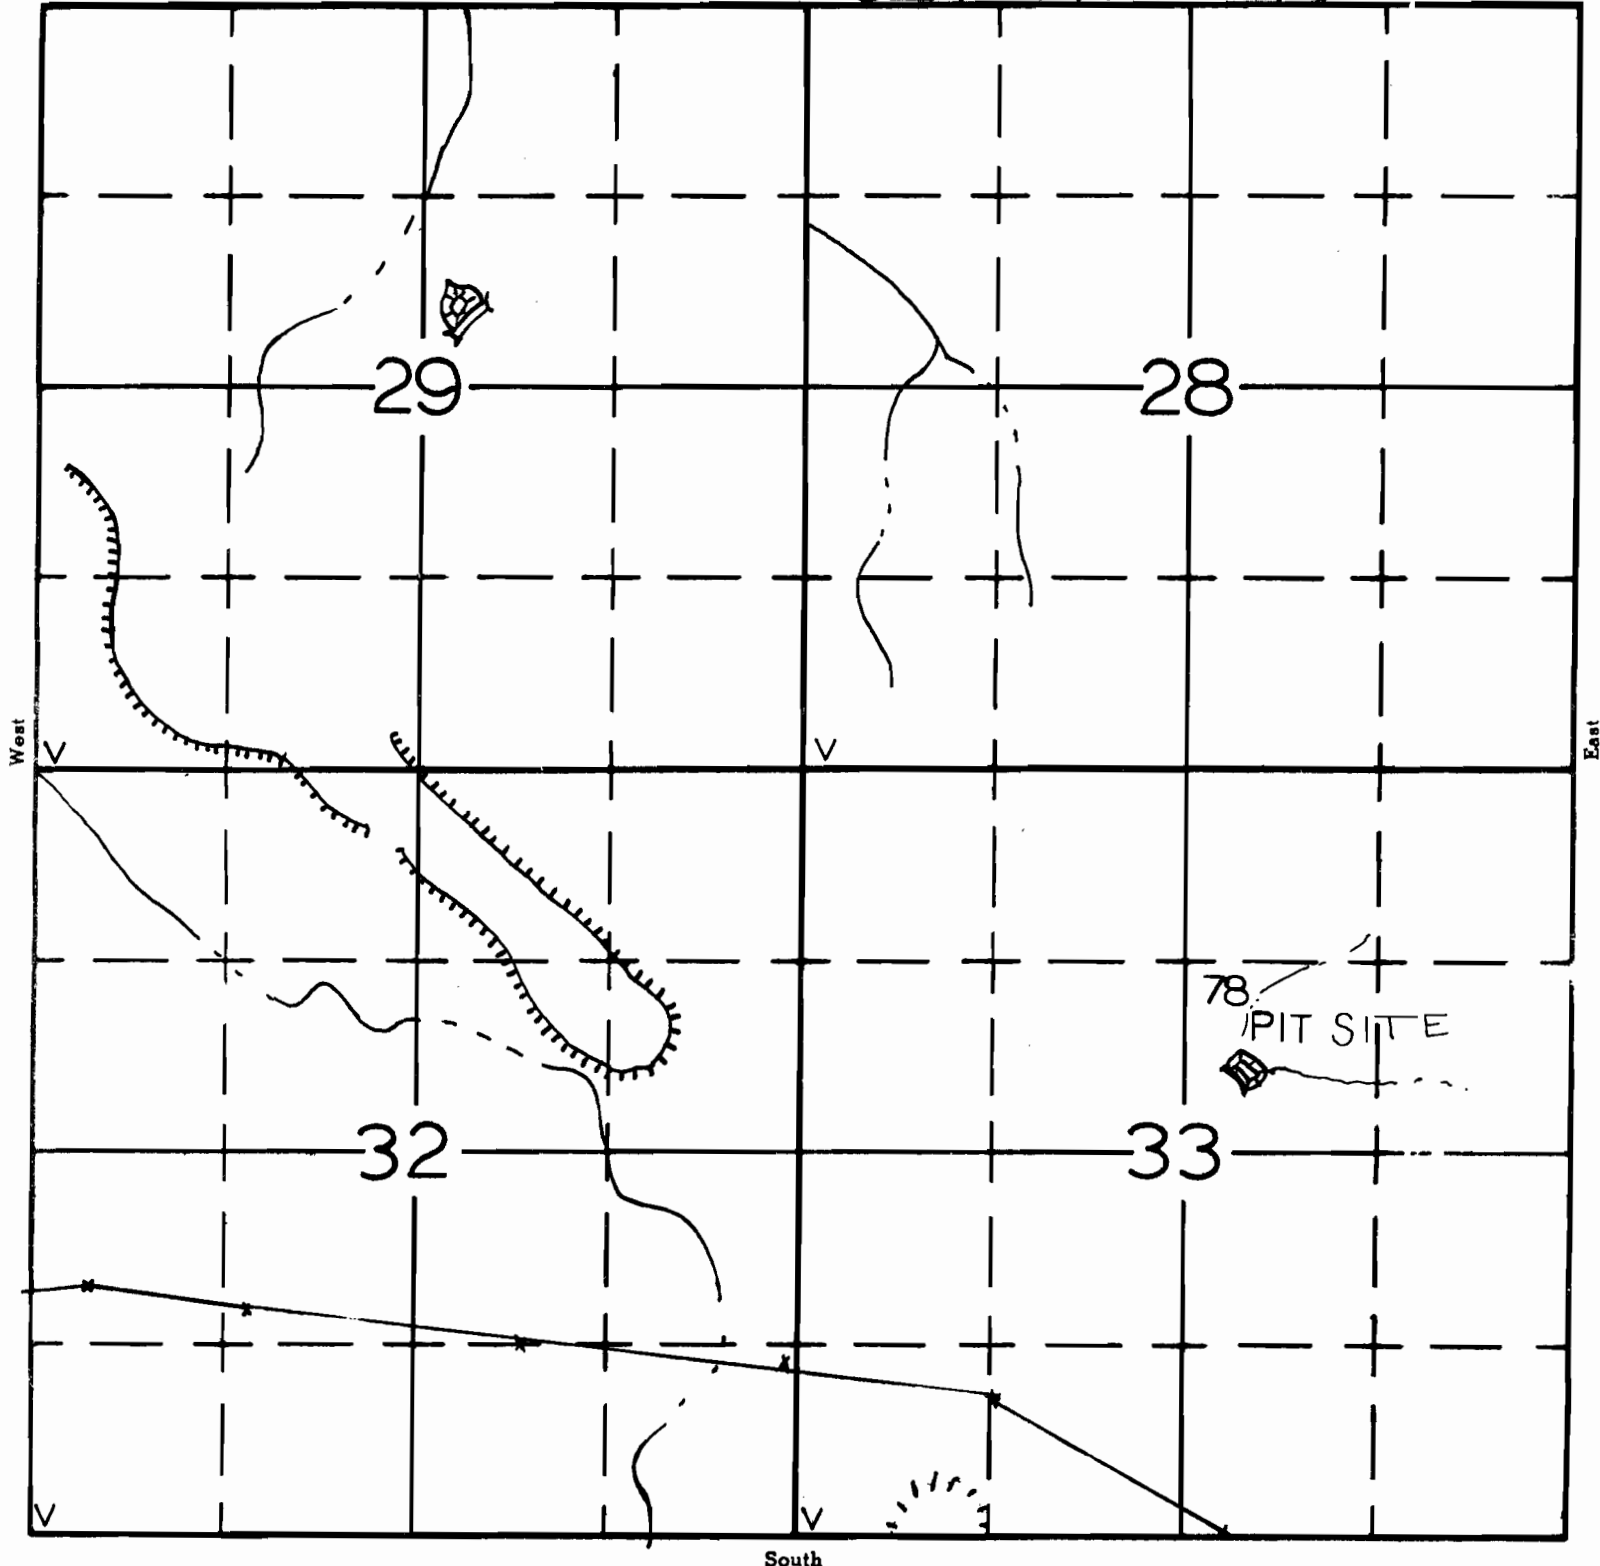

APPLICATION No. R67826

PERMIT No. R10648