
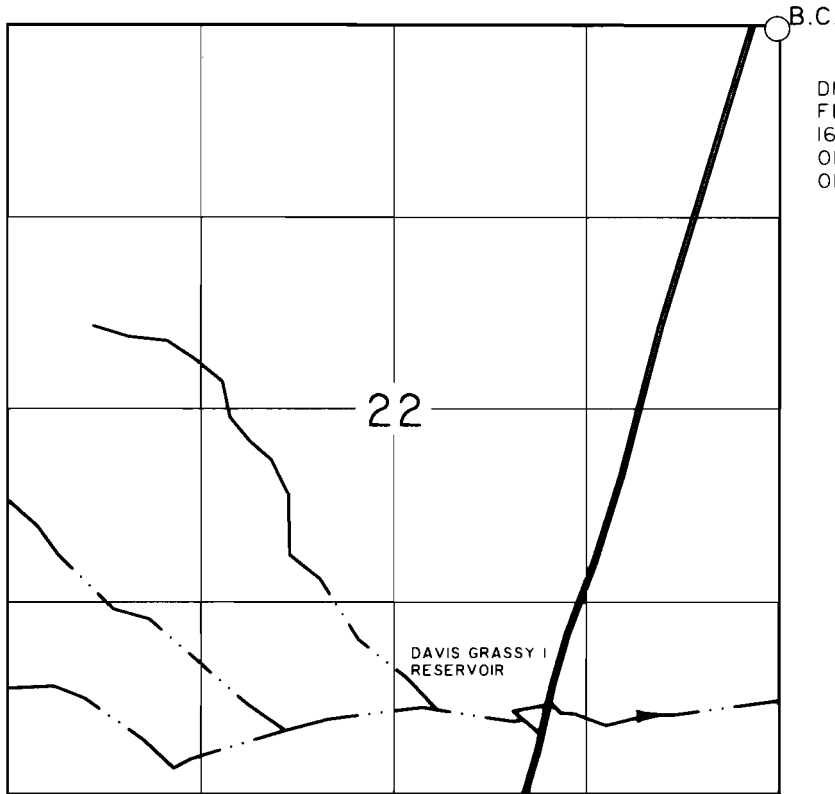


T. 32 S., R. 37 E., W.M.

SHEET 1 OF 3

RECEIVED

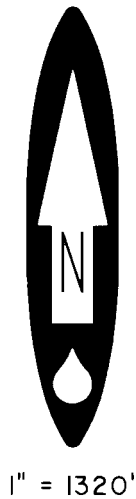

WATER RESOURCES
DIVISION 4770
FEET SOUTH AND
1615 FEET WEST
OF THE NE CORNER
OF SECTION 22.

RECEIVED

AUG 30 1999

WATER RESOURCES DEPT.
SALEM, OREGON


CLAIM OF BENEFICIAL USE MAP

IN NAME OF

UNITED STATES BUREAU OF LAND MANAGEMENT

APPLICATION NO. R-68502

PERMIT NO. R-12049

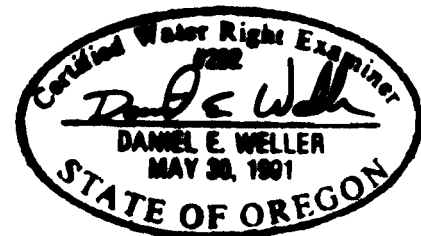

EXPIRES 6/30/00

SURVEYED: JUNE 29, 1999

THE PURPOSE OF THIS MAP IS FOR IDENTIFYING THE LOCATION OF THE WATER RIGHT ONLY AND
IS NOT INTENDED TO PROVIDE LEGAL DIMENSIONS OR LOCATION OF PROPERTY OWNERSHIP LINES.

U.S. BUREAU OF LAND MANAGEMENT-OSO
BRANCH OF GEOGRAPHIC SCIENCES

DWG: DAVISI

EXECUTED BY:
DANIEL E. WELLER, PLS, CWRE
P.O. BOX 2965
PORTLAND, OREGON 97208

T. 32 S., R. 37 E., W.M.


SHEET 2 OF 3

RECEIVED

AUG 30 1999

**WATER RESOURCES DEPT.
SALEM, OREGON**

DIVERSION IS 5260
FEET NORTH AND
2670 FEET EAST
OF THE SW CORNER
OF SECTION 34.

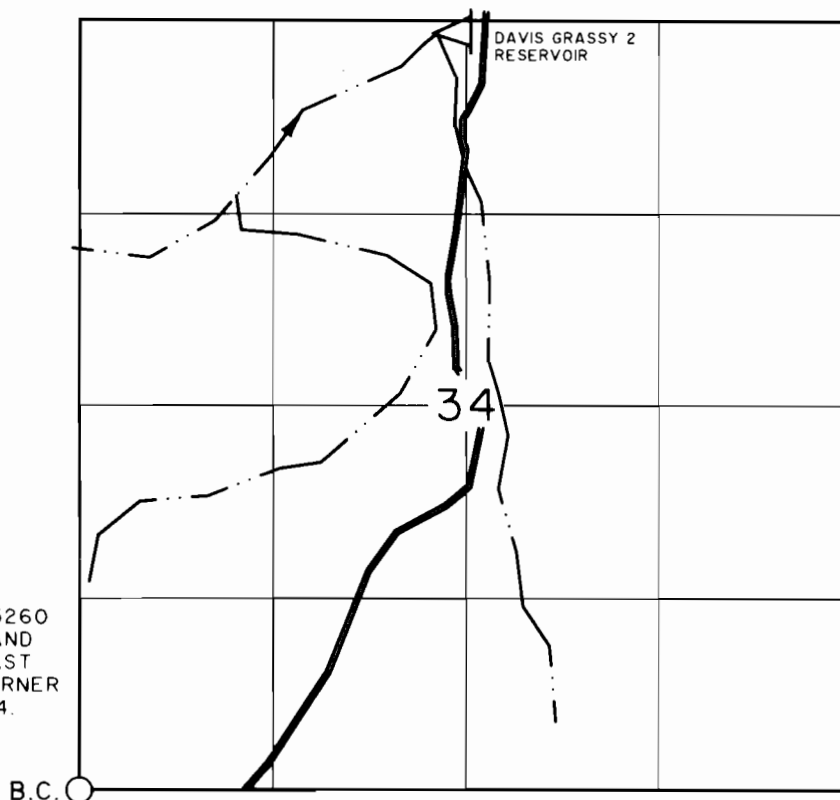


CLAIM OF BENEFICIAL USE MAP

IN NAME OF

UNITED STATES BUREAU OF LAND MANAGEMENT

APPLICATION NO. R-68502

PERMIT NO. R-12049

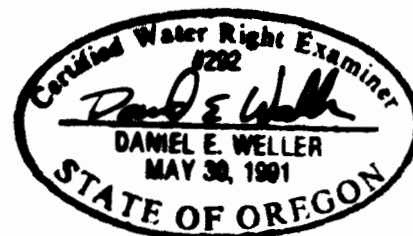

EXPIRES 6/30/00

SURVEYED: JUNE 29, 1999

THE PURPOSE OF THIS MAP IS FOR IDENTIFYING THE LOCATION OF THE WATER RIGHT ONLY AND
IS NOT INTENDED TO PROVIDE LEGAL DIMENSIONS OR LOCATION OF PROPERTY OWNERSHIP LINES

U.S. BUREAU OF LAND MANAGEMENT-OSO
BRANCH OF GEOGRAPHIC SCIENCES

DWG: DAVIS2


EXECUTED BY:
DANIEL E. WELLER, PLS, CWRE
P.O. BOX 2965
PORTLAND, OREGON 97208

T. 33 S., R. 37 E., W.M.

SHEET 3 OF 3



1" = 1320'

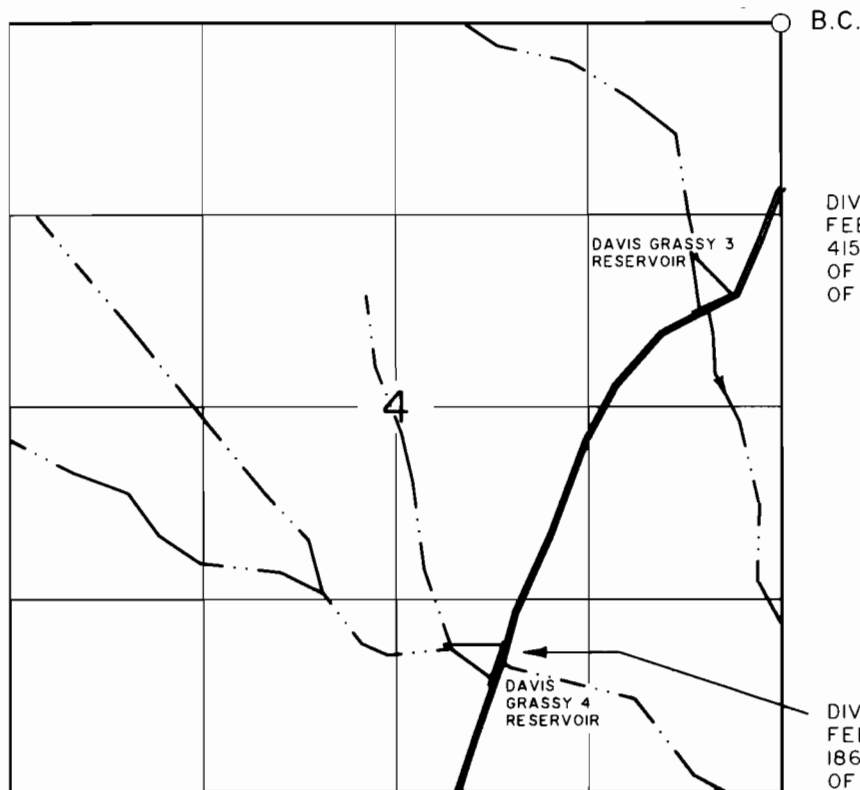

DIVERSION IS 1965
FEET SOUTH AND
415 FEET WEST
OF THE NE CORNER
OF SECTION 4.

RECEIVED

AUG 30 1999

**WATER RESOURCES DEPT
SALEM, OREGON**

DIVERSION IS 4350
FEET SOUTH AND
1865 FEET WEST
OF THE NE CORNER
OF SECTION 4.

CLAIM OF BENEFICIAL USE MAP

IN NAME OF

UNITED STATES BUREAU OF LAND MANAGEMENT

APPLICATION NO. R-68502

PERMIT NO. R-12049



EXPIRES 6/30/00

SURVEYED: JUNE 29, 1999

THE PURPOSE OF THIS MAP IS FOR IDENTIFYING THE LOCATION OF THE WATER RIGHT ONLY AND
IS NOT INTENDED TO PROVIDE LEGAL DIMENSIONS OR LOCATION OF PROPERTY OWNERSHIP LINES.

U.S. BUREAU OF LAND MANAGEMENT-OSO
BRANCH OF GEOGRAPHIC SCIENCES

DWG: DAVIS34

EXECUTED BY:
DANIEL E. WELLER, PLS, CWRE
P.O. BOX 2965
PORTLAND, OREGON 97208