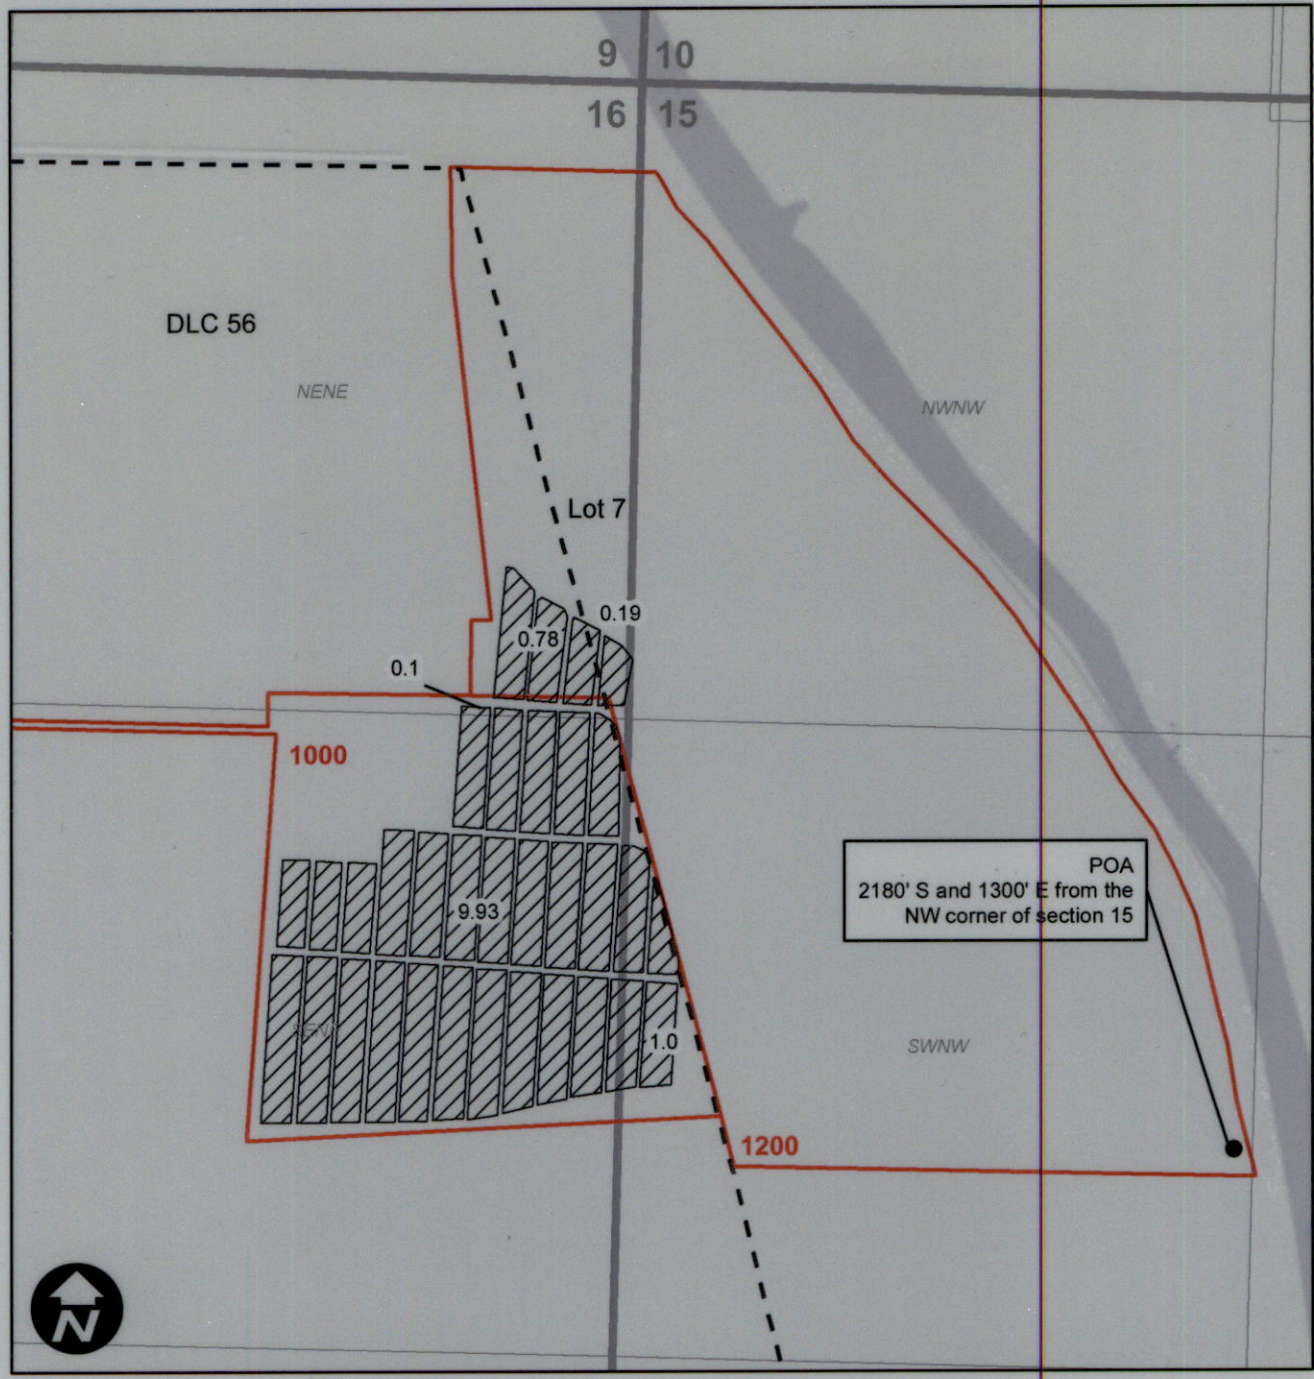
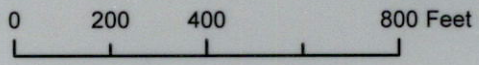


Transfer T-8469, Hildebrandt Claim of Beneficial Use

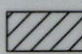
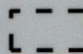
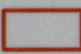
Township 5S, Range 3W, W.M.



This map is not intended to provide legal dimensions or locations of property ownership lines.



Legend

-  Developed POU
-  DLC
-  Tax Lot



EXPIRES: 12-31-2022