

UNITED STATES
DEPARTMENT OF THE INTERIOR
BUREAU OF LAND MANAGEMENT

OVERTOP
RESERVOIR


SECTION

Oregon State Water Filings

5206

NW 1/4 SE 4
SEC. 27

TOWNSHIP 21 S, RANGE 38 E, W. M.

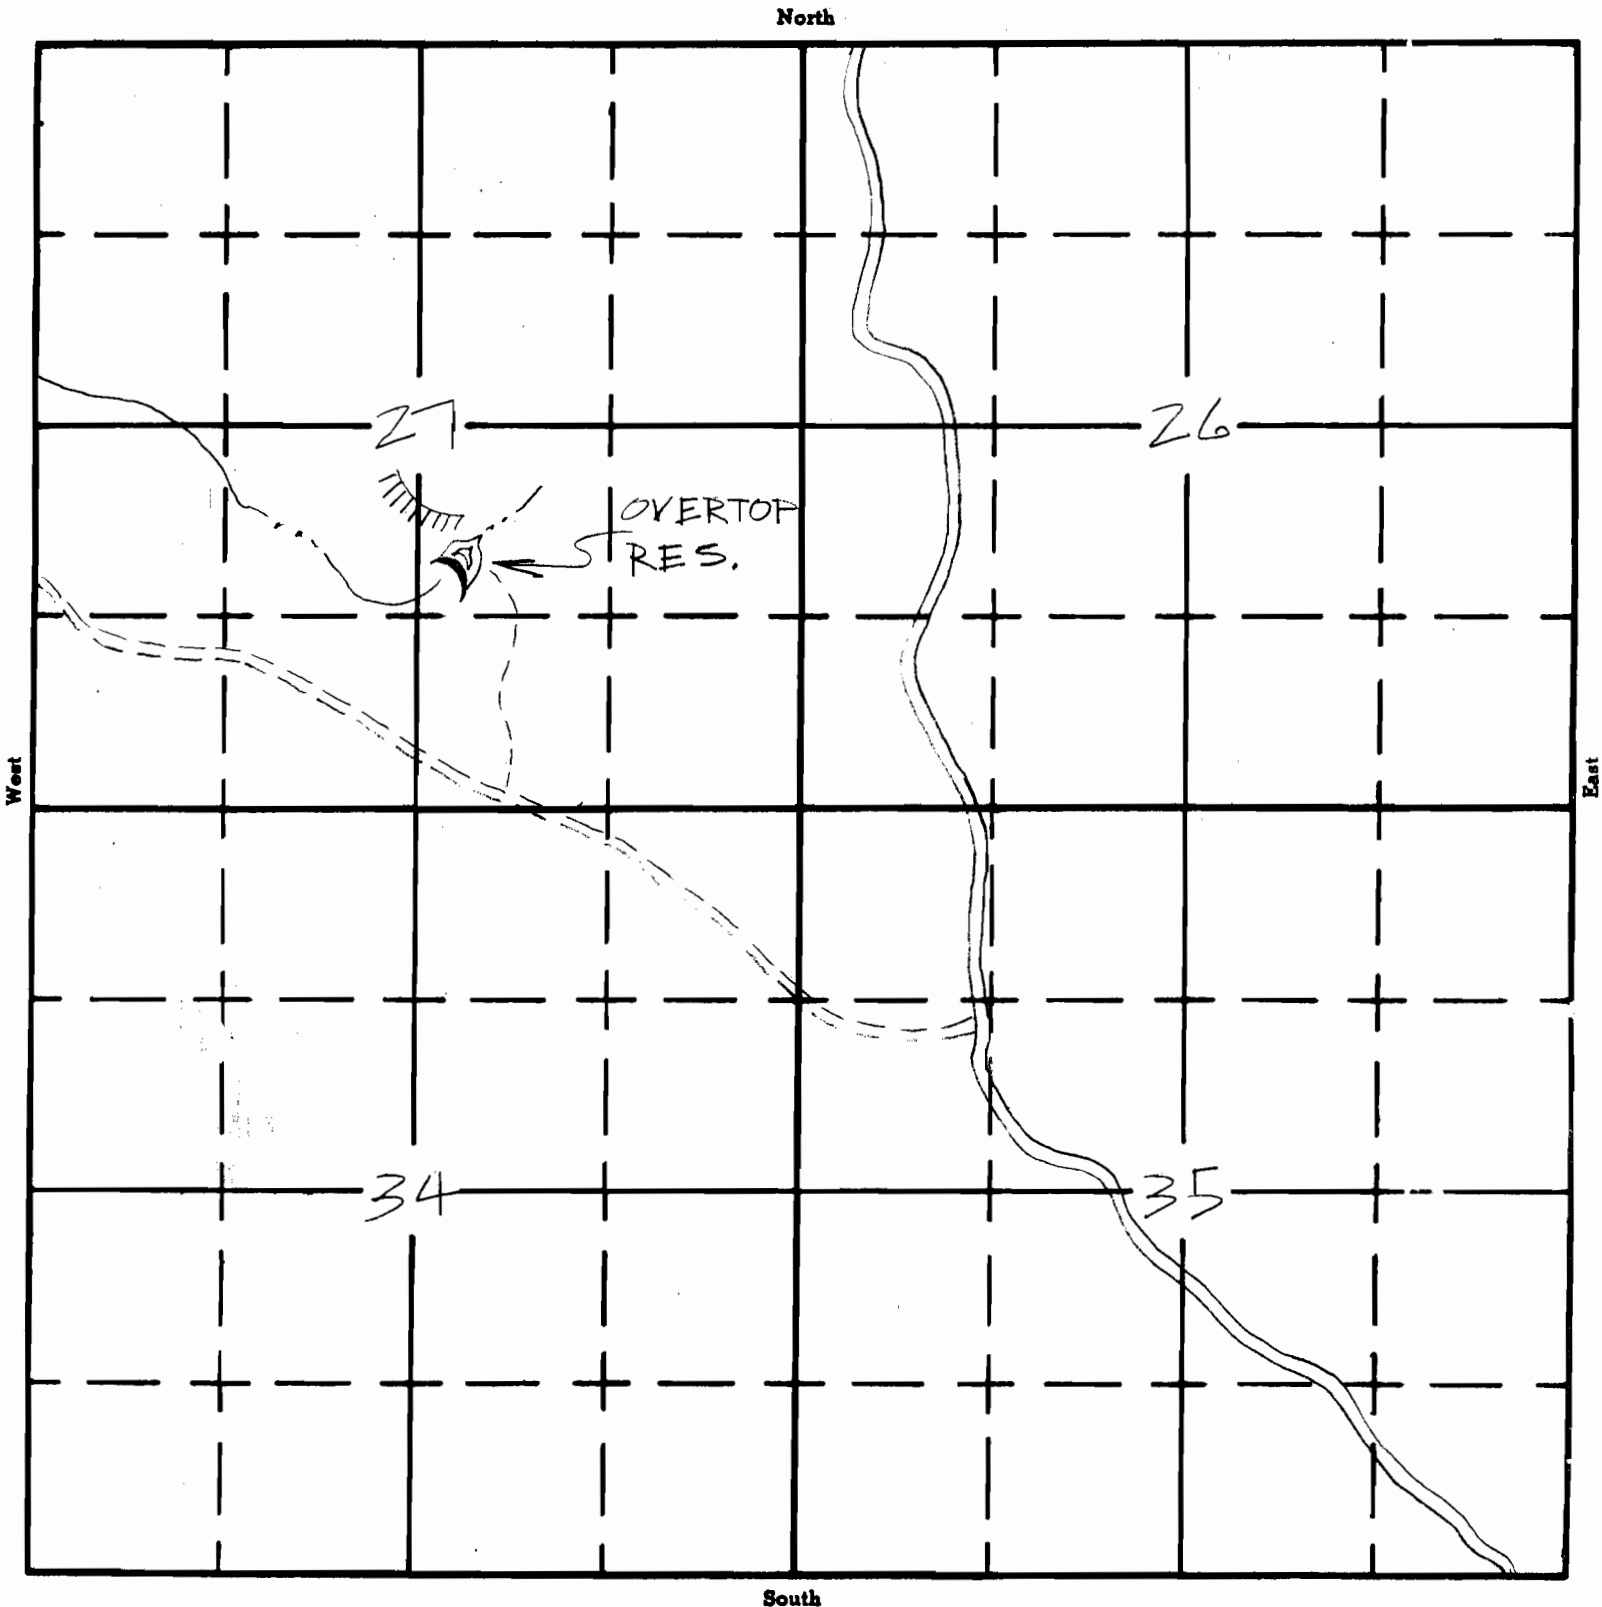

APPLICATION No. R-6875
PERMIT No. R-1111