


T31 S, R 28 E, WM

WATER RIGHTS
SALE OF OREGON

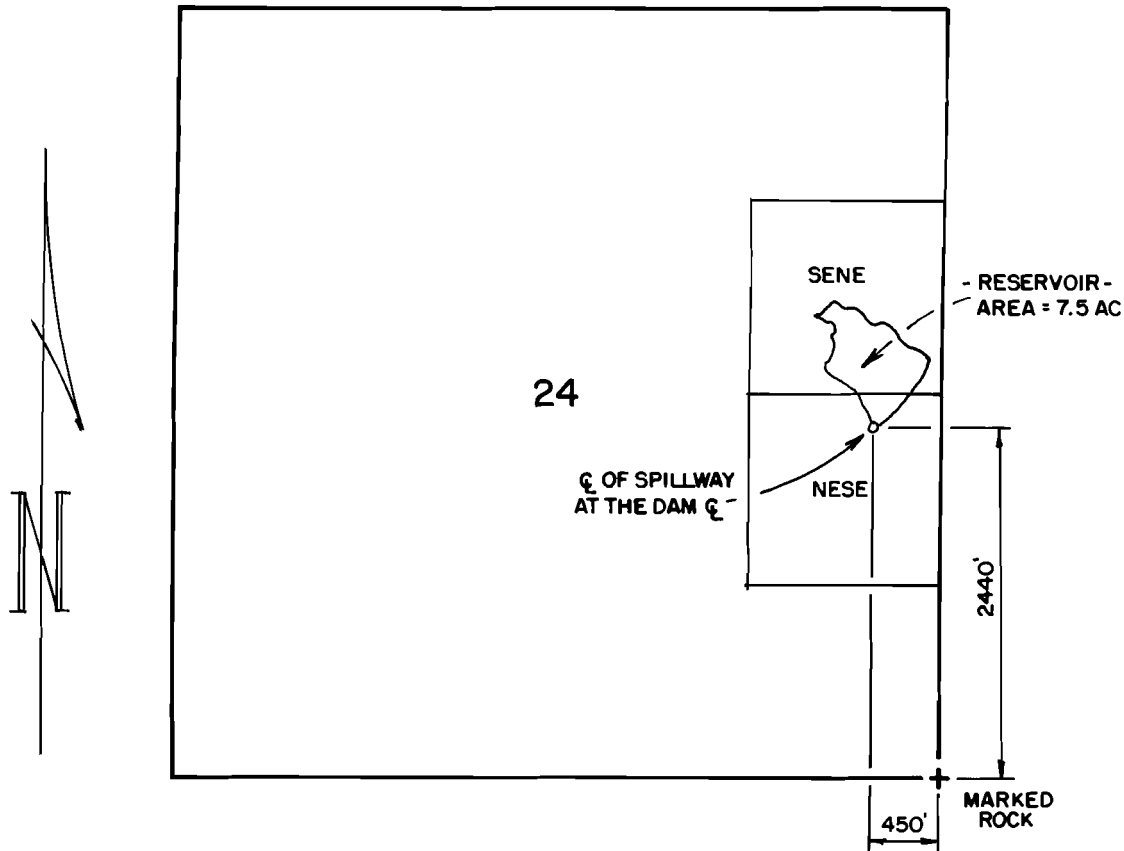

THE PURPOSE OF THIS MAP IS TO
IDENTIFY THE LOCATION OF THE
WATER RIGHT. IT IS NOT INTENDED
TO PROVIDE INFORMATION RELATIVE
TO THE LOCATION OF PROPERTY
OWNERSHIP.

FINAL PROOF SURVEY

UNDER
APPLICATION R-73618
PERMIT R-11825

IN THE NAME OF
ROCK CREEK RANCH INC

Scale: 4" = 1 MILE

Date: SEPT 2000

Job: 1429B

Dsn:

Drn: CHRIS

Ckd:

M.A.P's

M.A. PALMER & SONS, INC.
ENGINEERING & SURVEYING
711 Ponderosa Village • Box 61
Burns, Oregon 97720

Sht. No.

of 1

Chris T. Palmer
Nov. 19, 1997
STATE OF OREGON

RENEW 1-1-2001