


T. 37 S., R. 32 1/2 E., W.M.

DIVERSION IS 2285  
FEET SOUTH AND  
1440 FEET EAST OF  
THE NW CORNER OF  
SECTION 11.

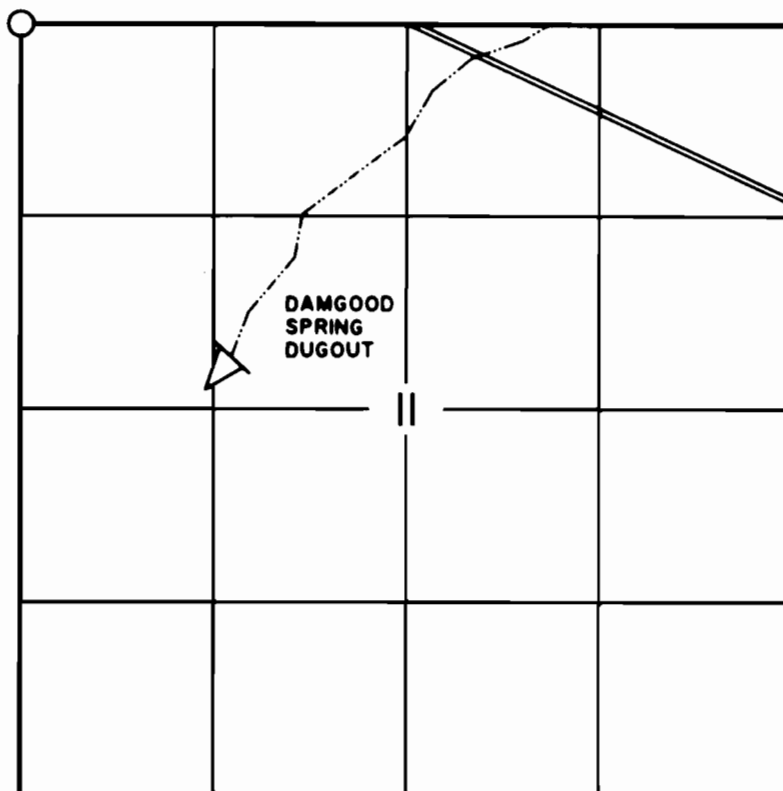

1" = 1320'

## CLAIM OF BENEFICIAL USE MAP

IN NAME OF


UNITED STATES BUREAU OF LAND MANAGEMENT

APPLICATION NO. R-68522

PERMIT NO. R-III22

**RECEIVED****OCT 02 2000**WATER RESOURCES DEPT.  
SALEM, OREGON

SURVEYED: MAY 23, 2000

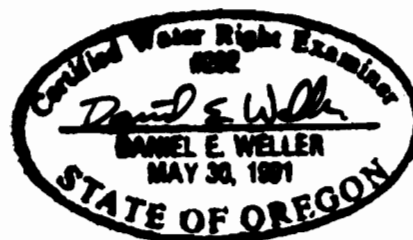

EXPIRES JUNE 30, 2002

THE PURPOSE OF THIS MAP IS FOR IDENTIFYING THE LOCATION OF THE WATER RIGHT ONLY AND  
IS NOT INTENDED TO PROVIDE LEGAL DIMENSIONS OR LOCATION OF PROPERTY OWNERSHIP LINES.

BLM PROJECT NO. OR-5415


U.S. BUREAU OF LAND MANAGEMENT-OSO  
BRANCH OF CADASTRAL SURVEY  
DWG: DAMGOOD

EXECUTED BY:  
DANIEL E. WELLER, PLS, CWRE  
P.O. BOX 2965  
PORTLAND, OREGON 97208

T. 37 S., R. 32 1/2 E., W.M.



1" = 1320'

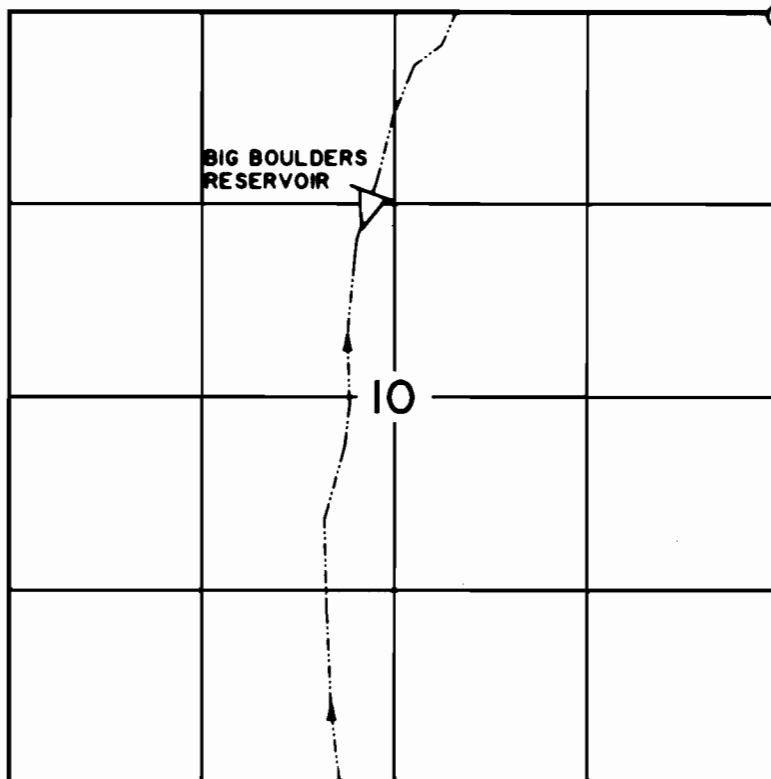

DIVERSION IS 1250  
FEET SOUTH AND  
2790 FEET WEST  
OF THE NE CORNER  
OF SECTION 10.

## CLAIM OF BENEFICIAL USE MAP

IN NAME OF

UNITED STATES BUREAU OF LAND MANAGEMENT

APPLICATION NO. R-68522


PERMIT NO. R-III22

**RECEIVED**

OCT 02 2000

WATER RESOURCES DEPT.  
SALEM, OREGON

SURVEYED: MAY 23, 2000

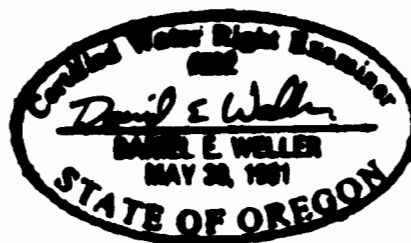

EXPIRES JUNE 30, 2002

THE PURPOSE OF THIS MAP IS FOR IDENTIFYING THE LOCATION OF THE WATER RIGHT ONLY AND  
IS NOT INTENDED TO PROVIDE LEGAL DIMENSIONS OR LOCATION OF PROPERTY OWNERSHIP LINES.

BLM PROJECT NO. OR-5416

U.S. BUREAU OF LAND MANAGEMENT-OSO  
BRANCH OF CADASTRAL SURVEY  
DWG: BIG BOULDERS

EXECUTED BY:  
DANIEL E. WELLER, PLS, CWRE  
P.O. BOX 2965  
PORTLAND, OREGON 97208


SECTION

11 SE NW  
10 NE NW

69-5415 Damgood Spring Res  
09-5416 Big Boulders Res

TOWNSHIP 37 S, RANGE 32 1/2 E, W. M.

North

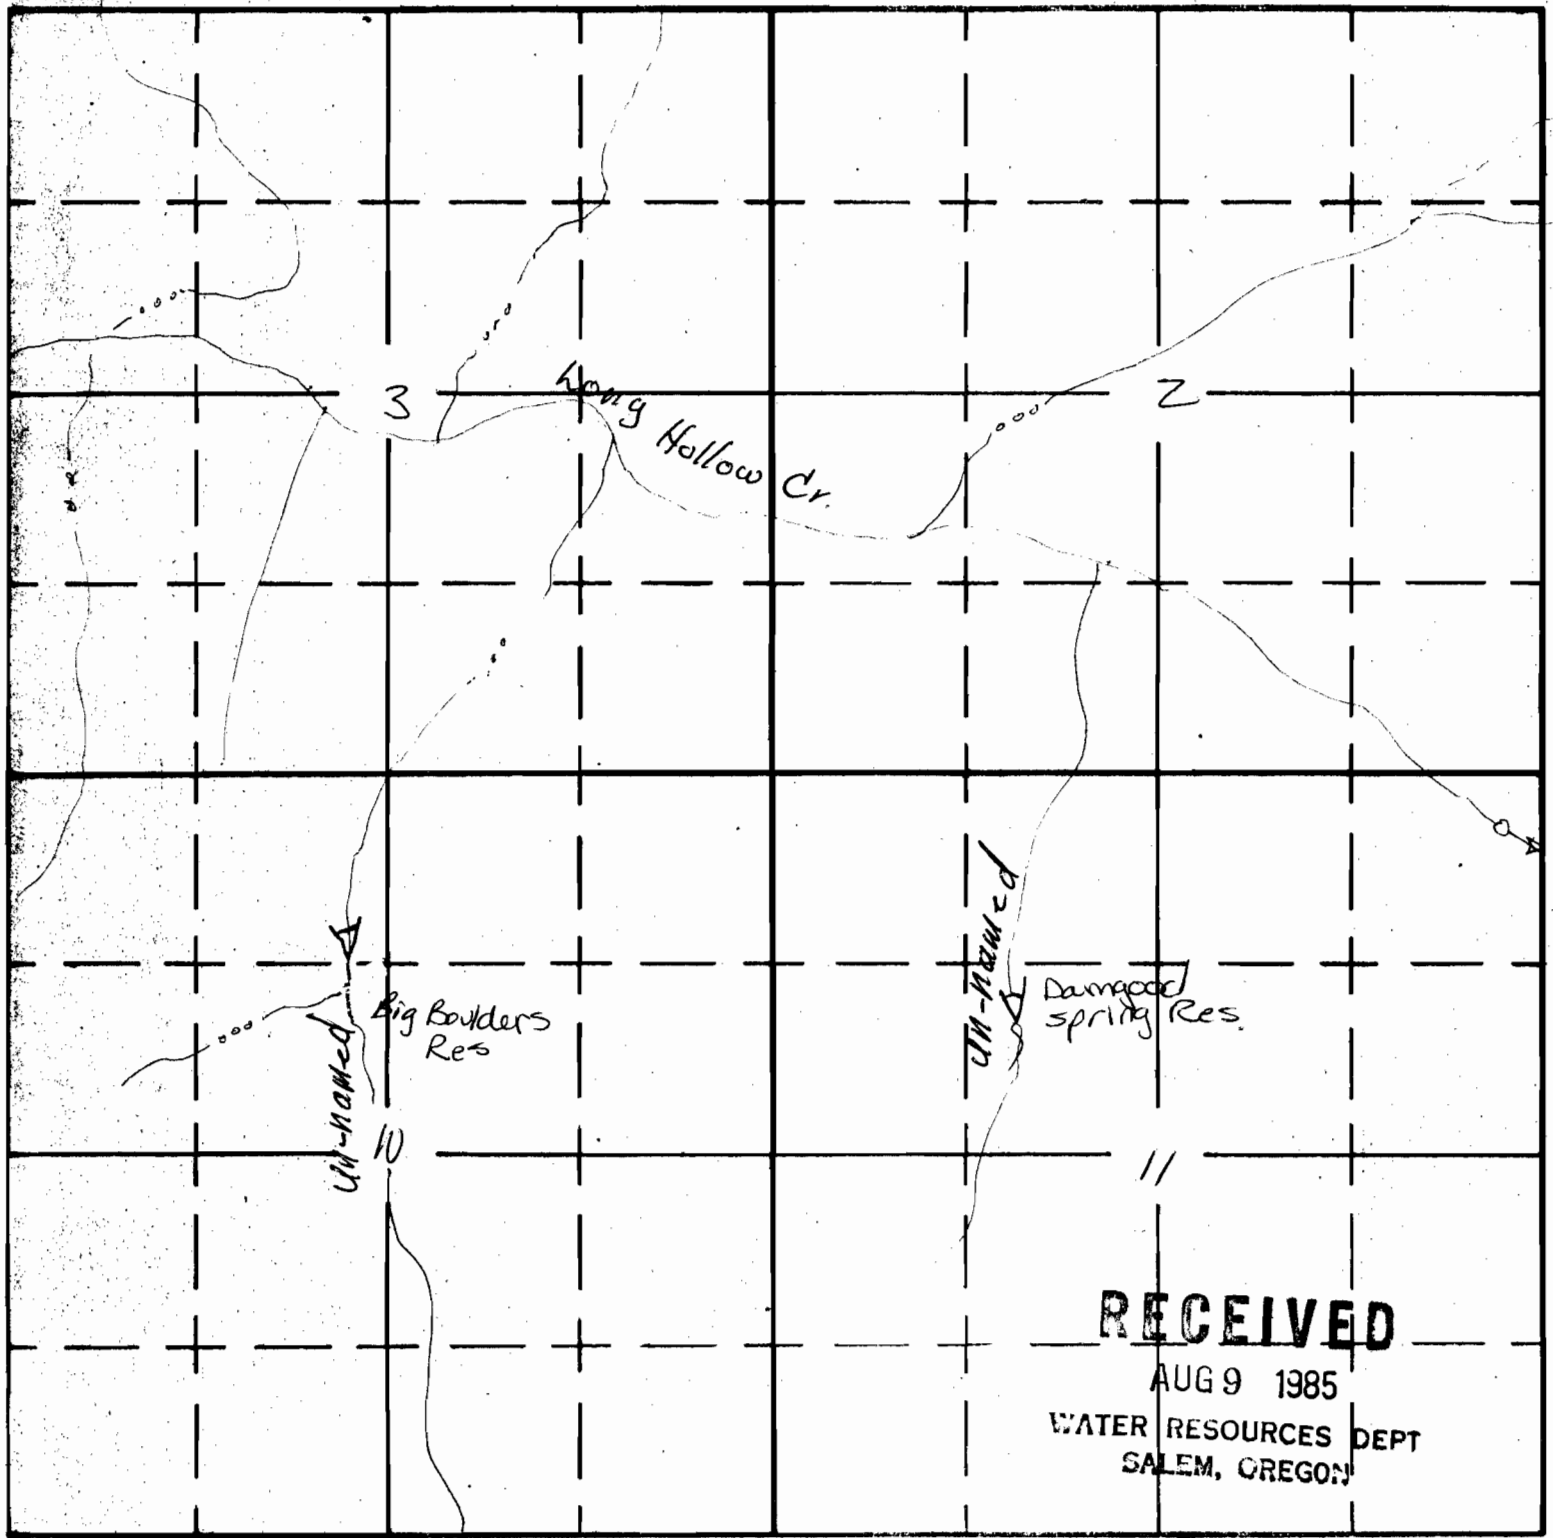

RECEIVED

AUG 9 1985  
WATER RESOURCES DEPT  
SALEM, OREGON

RECEIVED

MAR 20 1986  
WATER RESOURCES DEPT  
SALEM, OREGON

APPLICATION NO R-68522

PERMIT NQ R11122