


T. 32 S., R. 37 E., W.M.

RECEIVED

AUG 30 1989

WATER RESOURCES DEPT.
SALEM, OREGON

DIVERSION IS 160
FEET SOUTH AND
410 FEET EAST
OF THE NW CORNER
OF SECTION 9.

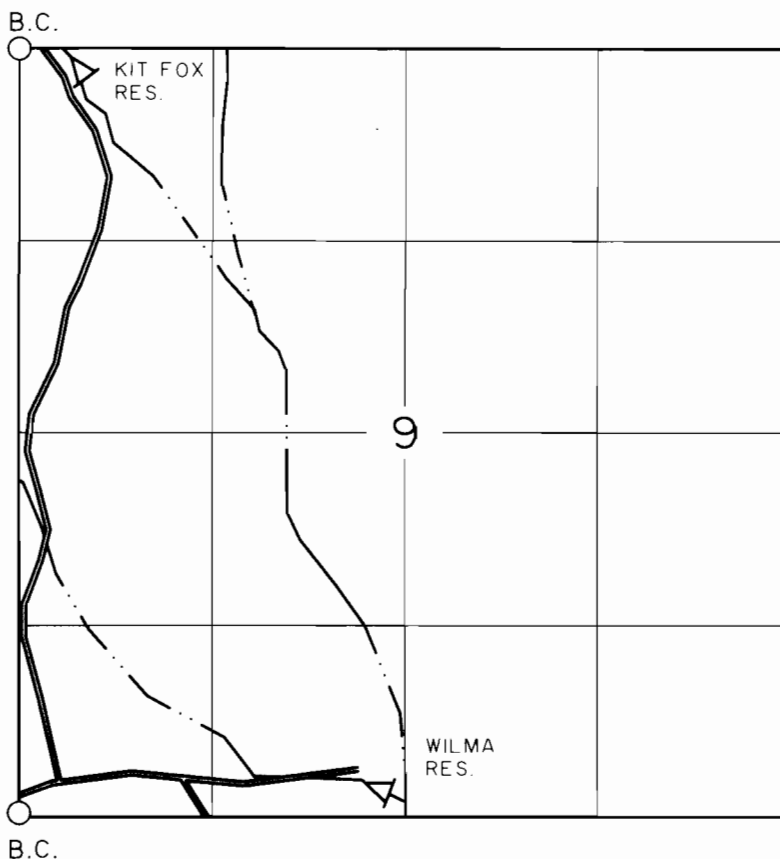

DIVERSION IS 165
FEET NORTH AND
2470 FEET EAST
OF THE SW CORNER
OF SECTION 9.


CLAIM OF BENEFICIAL USE MAP

IN NAME OF

UNITED STATES BUREAU OF LAND MANAGEMENT

APPLICATION NO. R-68524

PERMIT NO. R-11708

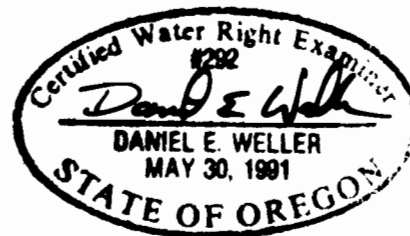

EXPIRES 6/30/00

SURVEYED: JUNE 29, 1999

THE PURPOSE OF THIS MAP IS FOR IDENTIFYING THE LOCATION OF THE WATER RIGHT ONLY AND
IS NOT INTENDED TO PROVIDE LEGAL DIMENSIONS OR LOCATION OF PROPERTY OWNERSHIP LINES

U.S. BUREAU OF LAND MANAGEMENT-OSO
BRANCH OF GEOGRAPHIC SCIENCES

DWG: WILMA

EXECUTED BY:
DANIEL E. WELLER, PLS, CWRE
P.O. BOX 2965
PORTLAND, OREGON 97208


SECTION

9 NNNW
4 SESW

TOWNSHIP 32 **S**, RANGE 37 **E**, W. M. ¹⁰⁻⁵⁴⁴⁵
Wilma Res.

^{10-#5405}
Kit Fox Res.

North

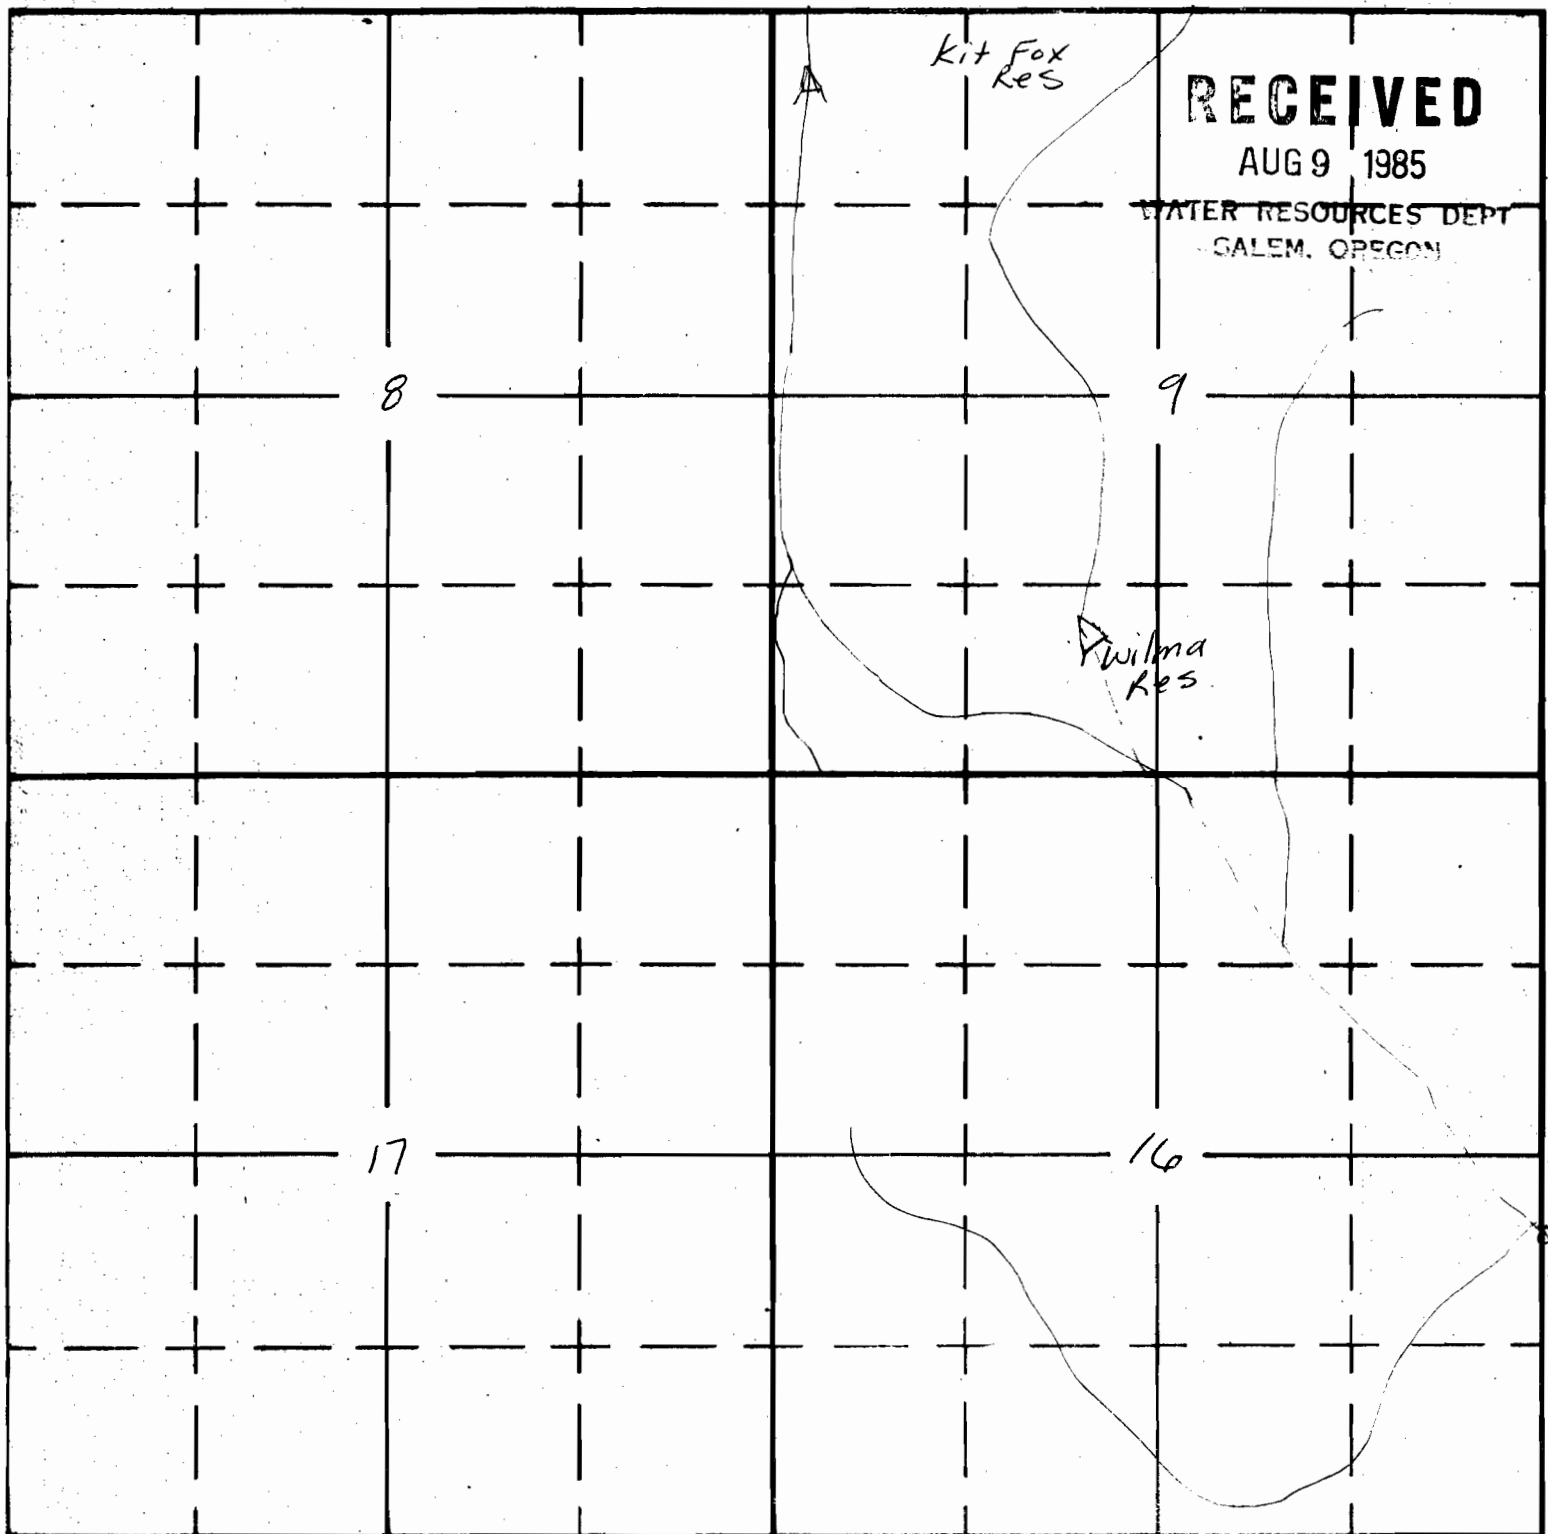

South

APPLICATION NO R-68524

PERMIT NQ R11708

RECEIVED

MAR 20 1986

WATER RESOURCES DEPT
SALEM, OREGON