


HART MOUNTAIN
NATIONAL ANTELOPE REFUGE



HB 2153 POND LOCATIONS

Application No. R-75576
Permit No.
ALGER LAKE QUADRANGLE
OREGON-LAKE CO.
7.5 MINUTE SERIES (TOPOGRAPHIC)

UNITED STATES
DEPARTMENT OF THE INTERIOR
GEOLOGICAL SURVEY

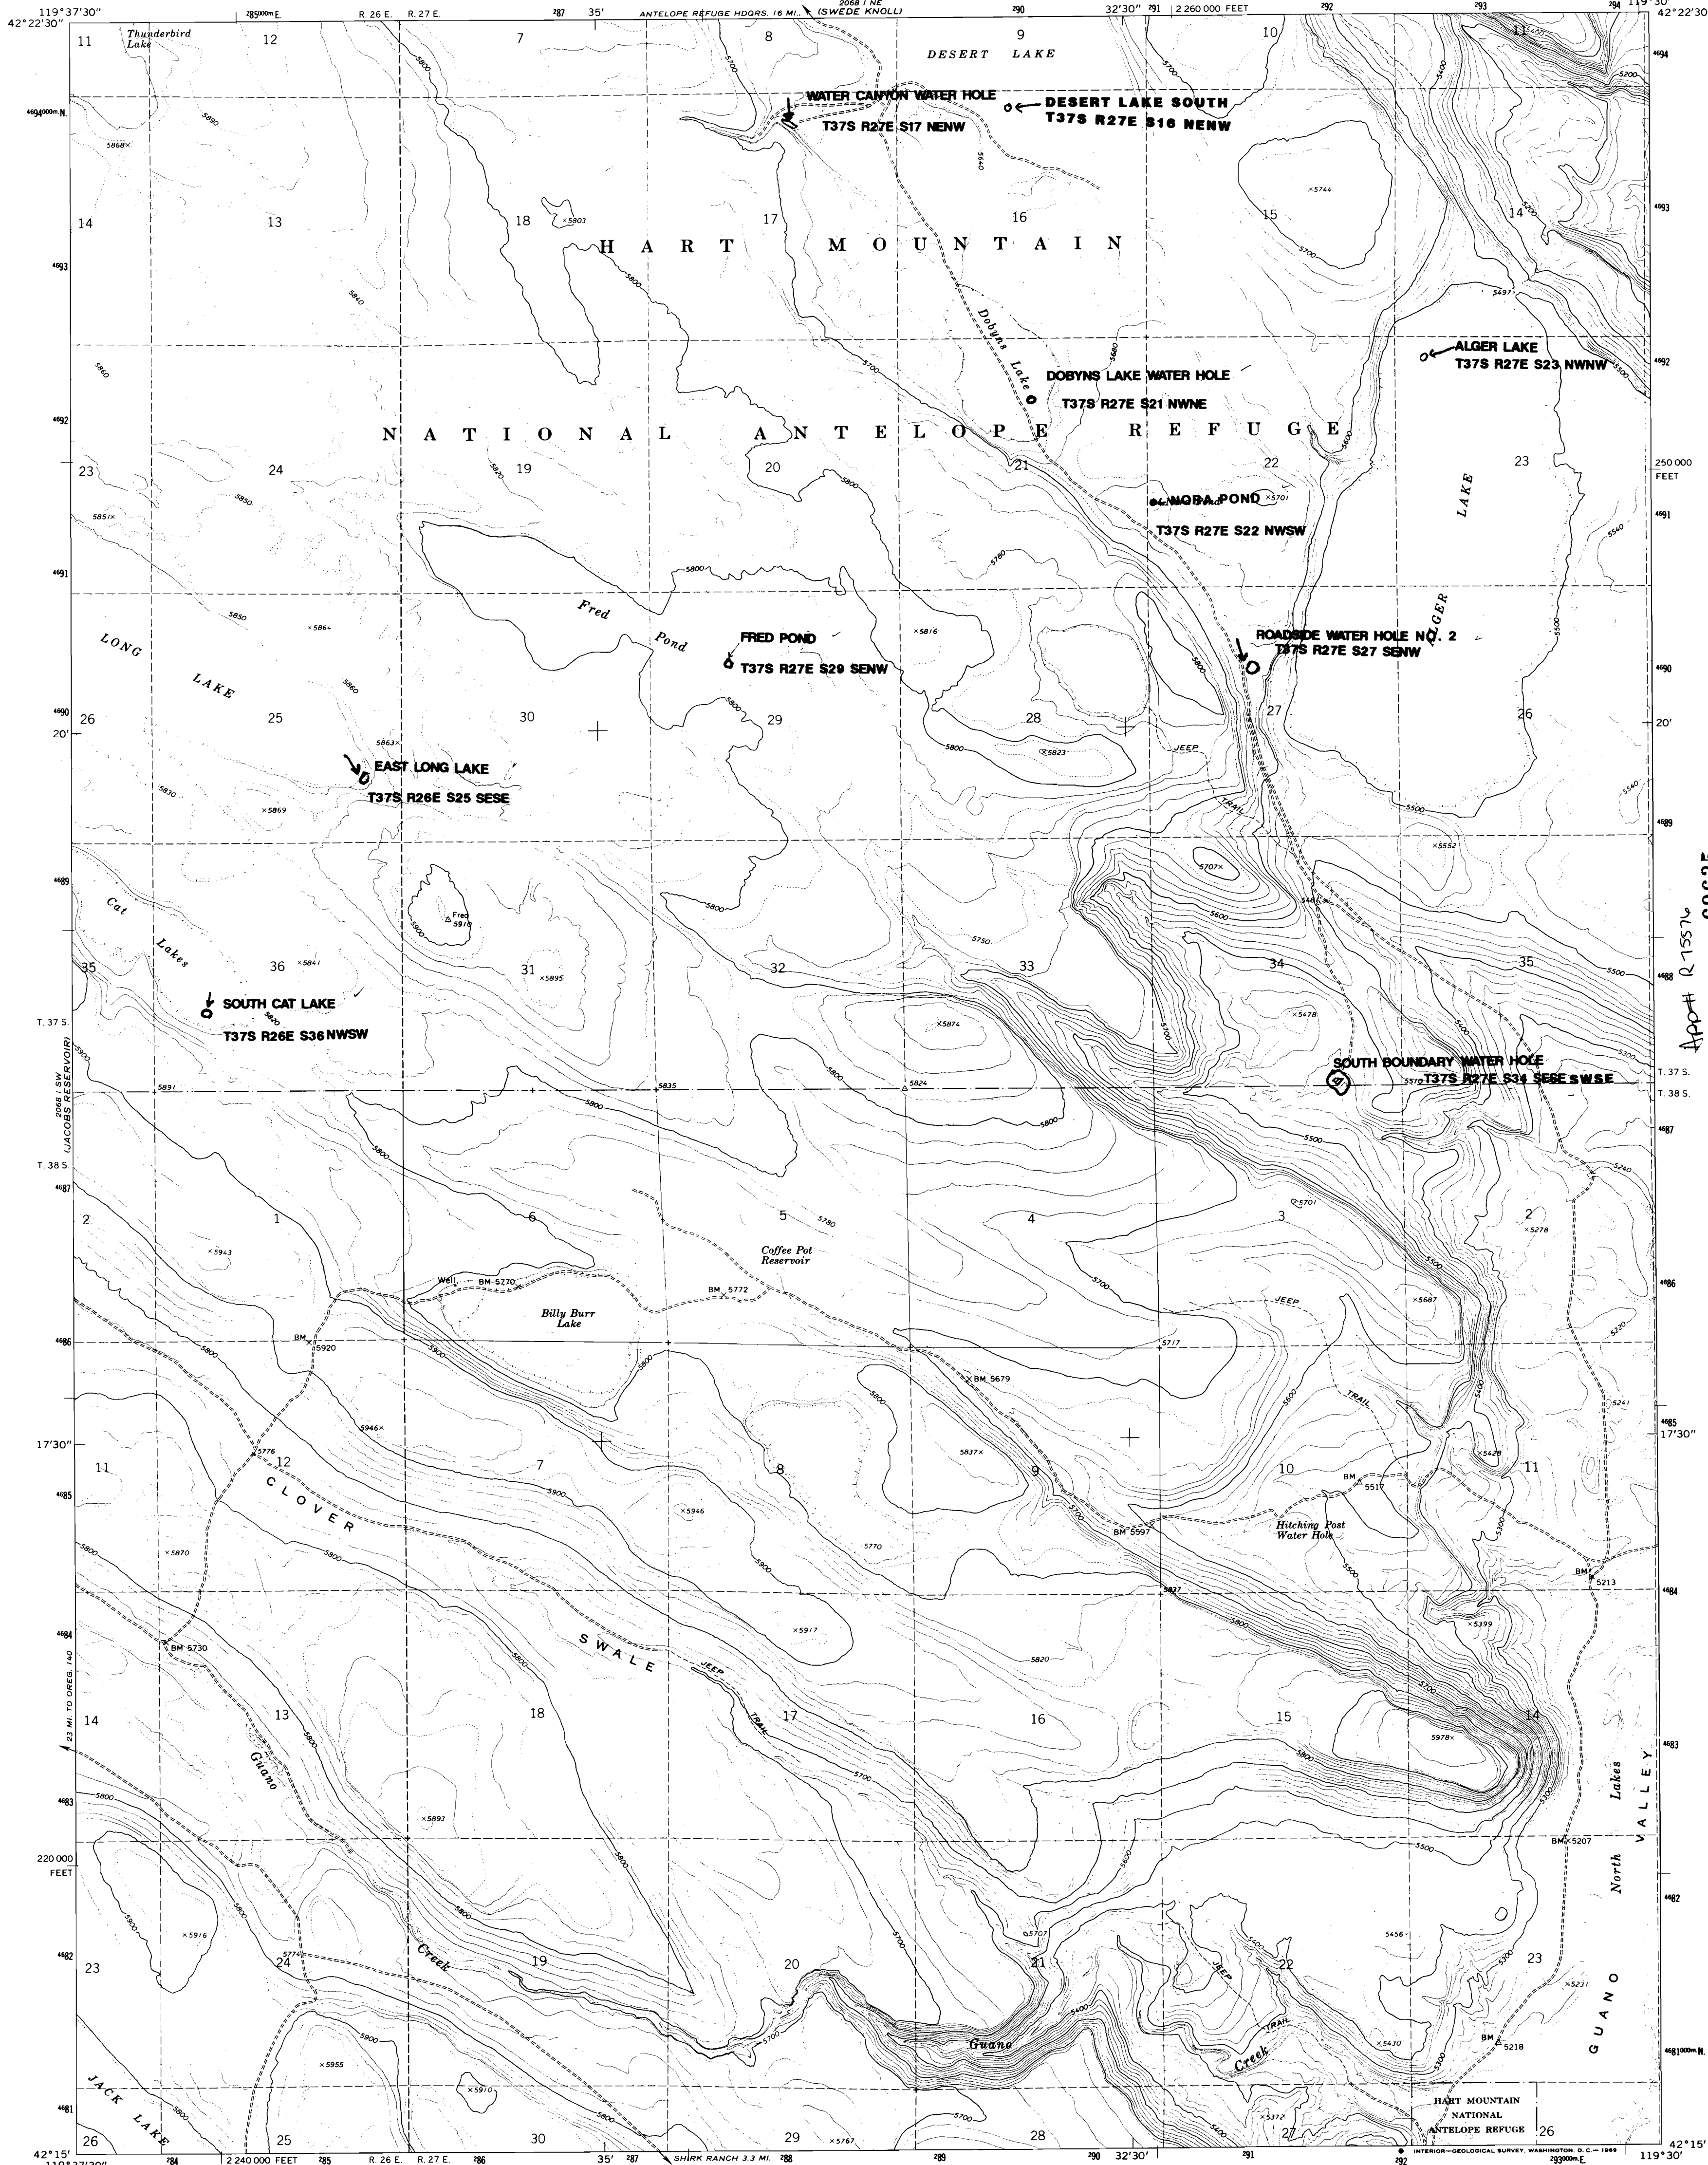

Mapped, edited, and published by the Geological Survey
Control by USGS and USC&GS
Topography by photogrammetric methods from aerial
photographs taken 1964. Field checked 1967
Polyconic projection. 1927 North American datum
10,000-foot grid based on Oregon coordinate system,
south zone
1000-meter Universal Transverse Mercator grid ticks,
zone 11, shown in blue
Fine red dashed lines indicate selected fence lines

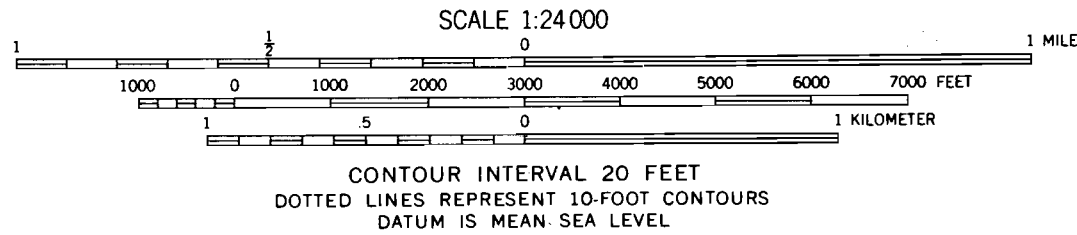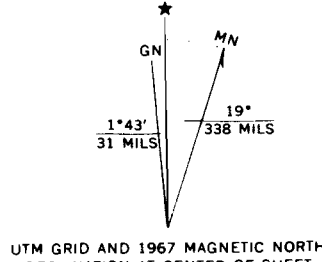

THIS MAP COMPLIES WITH NATIONAL MAP ACCURACY STANDARDS
FOR SALE BY U.S. GEOLOGICAL SURVEY, DENVER, COLORADO 80225 OR WASHINGTON, D. C. 20242



ROAD CLASSIFICATION
Unimproved dirt -----

ALGER LAKE, OREG.
N4215-W11930/7.5

NOV 2 1994
WATER RES.
SALEM, O.

App# R-75576
CERTIFICATE NO. 02635