RECEIVED
WATER RESOURCES DEPT.
SALEM, OREGON

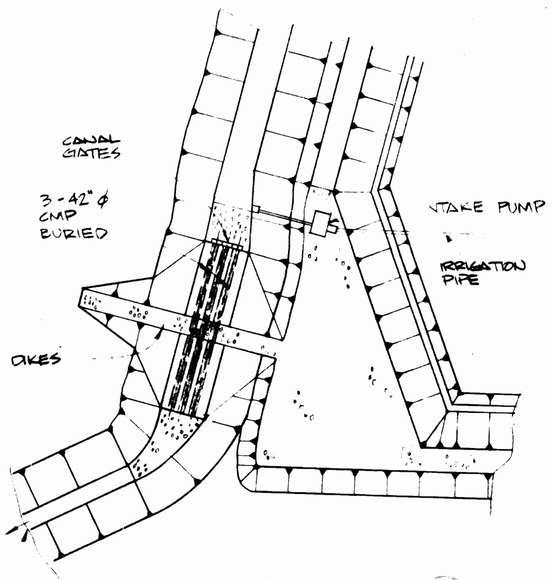

INTAKE DETAIL
SCALE: 1" = 30'

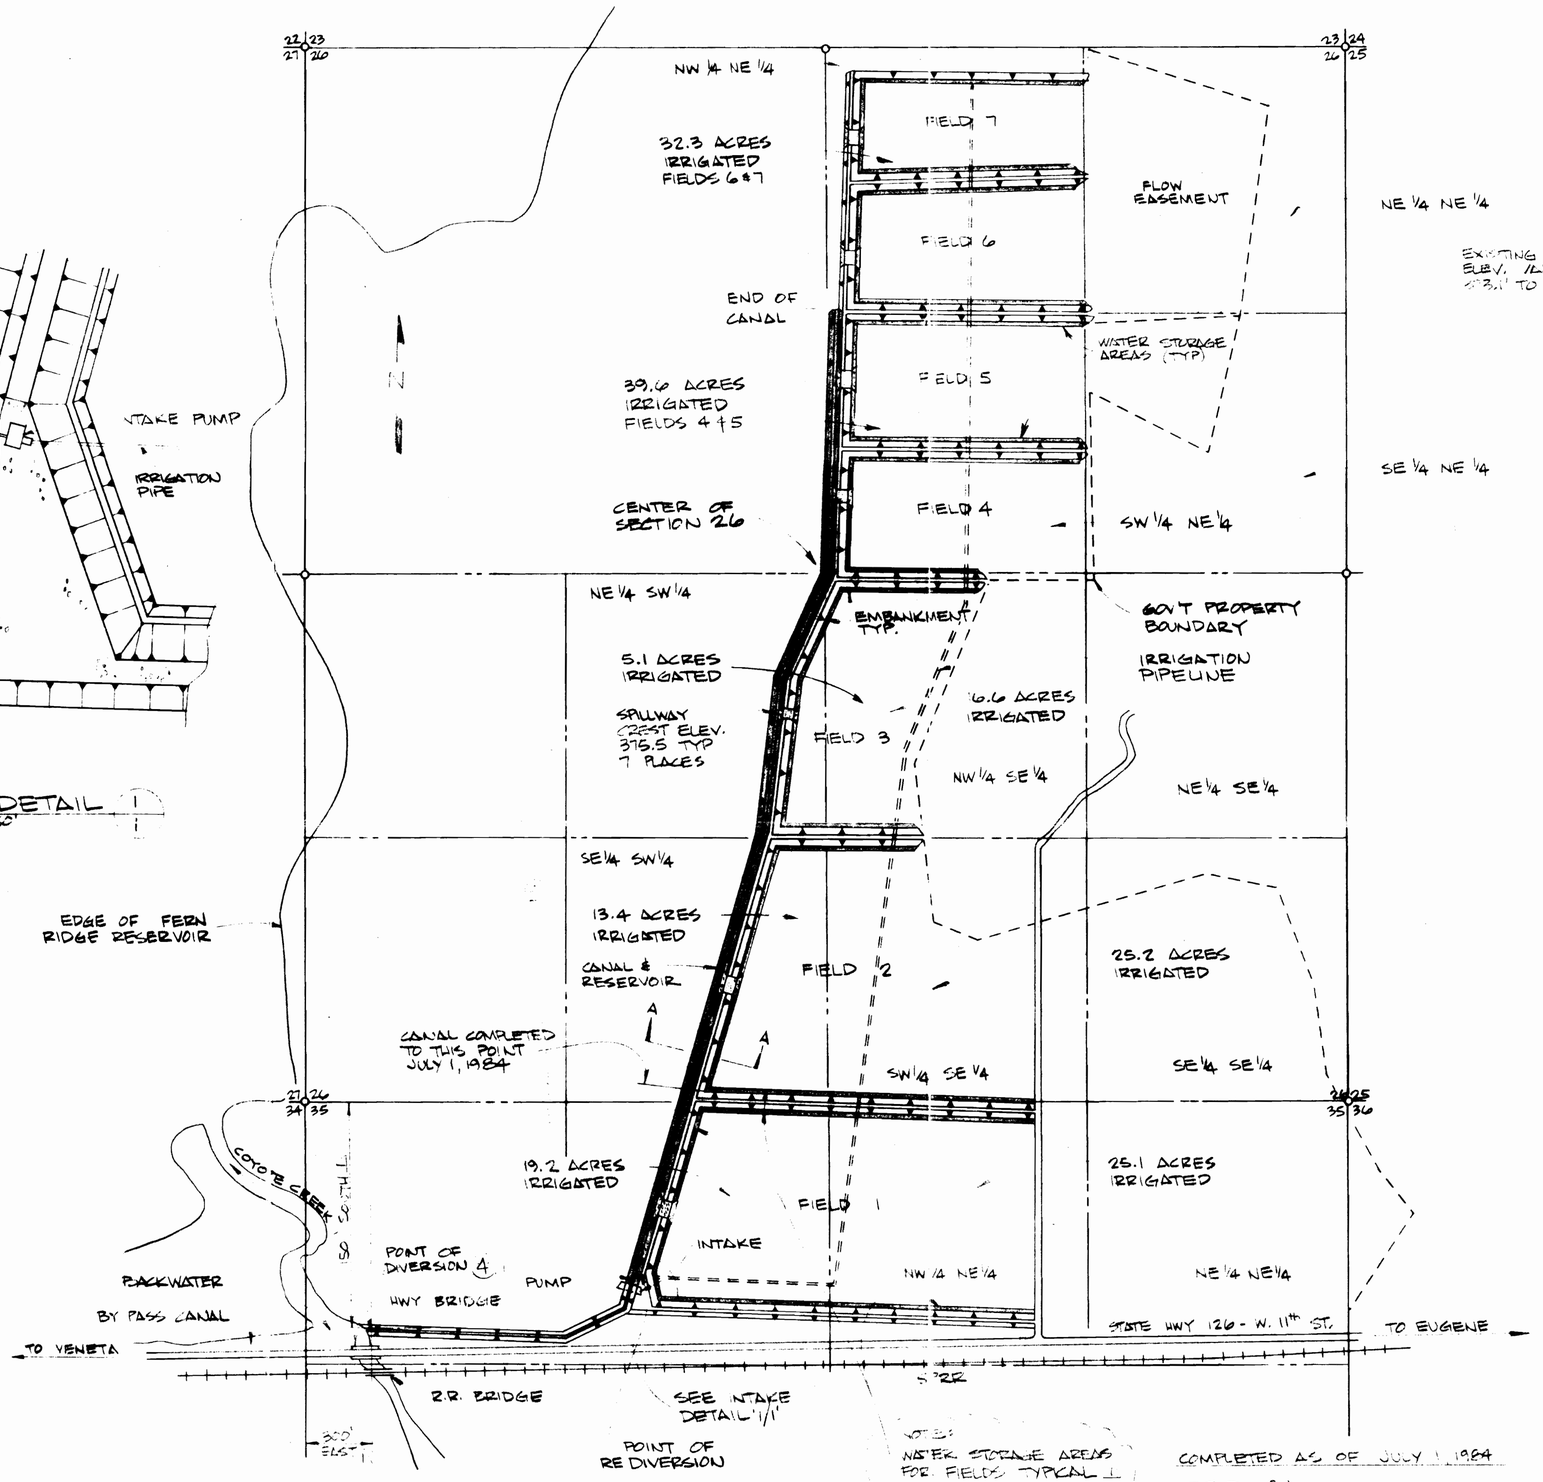

SITE PLAN
SCALE: 1" = 400'

T17S R5W W.M. SEC'S 26 & 35

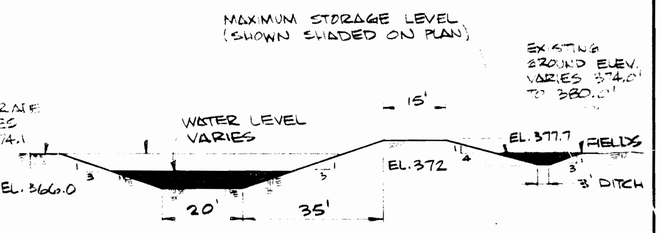

SECTION A-A
1" = 20'

WATER RESOURCES DEPARTMENT
APPROVED: Oct 7 19 86
William N. Young
ENGINEER

DEPARTMENT OF WATER RESOURCES
EUGENE JUNCTION

Application No. 68043 & R-68679
Permit No. 49870 R10814

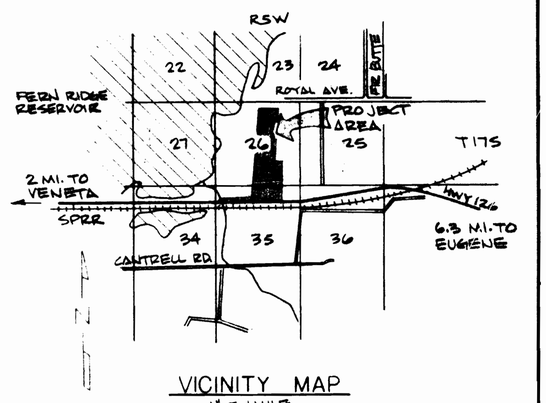

VICINITY MAP
1" = 1 MILE

COMPLETED AS OF JULY 1, 1984

- FIELD NO 1
- CANAL FOR FIELD NO 1
- INTAKE AND IRRIGATION PIPELINE TO FIELD NO 7

TO BE COMPLETED

- INTAKE DIKES & CANAL GATES
- FIELDS 2 THRU 7
- CANAL FROM FIELD 2 THRU 5

REVISIONS	
8-27-86	ADD POINT OF DIVERSION & NOTE

CHIEF ENGINEER
DATE FEB. 19, 1986
DESIGN BY ODFW
DRAWN BY BJ
CHECKED BY PRJ

DEPARTMENT OF FISH & WILDLIFE
STATE OF OREGON

FERN RIDGE W.M.A.
PHASE II DEVELOPMENT

SITE PLAN

APP'VD DIRECTOR
FILE NO. 8516 SHT. 1 OF 1

BRUNING 40-107