


T.2N,R.12E,WM.

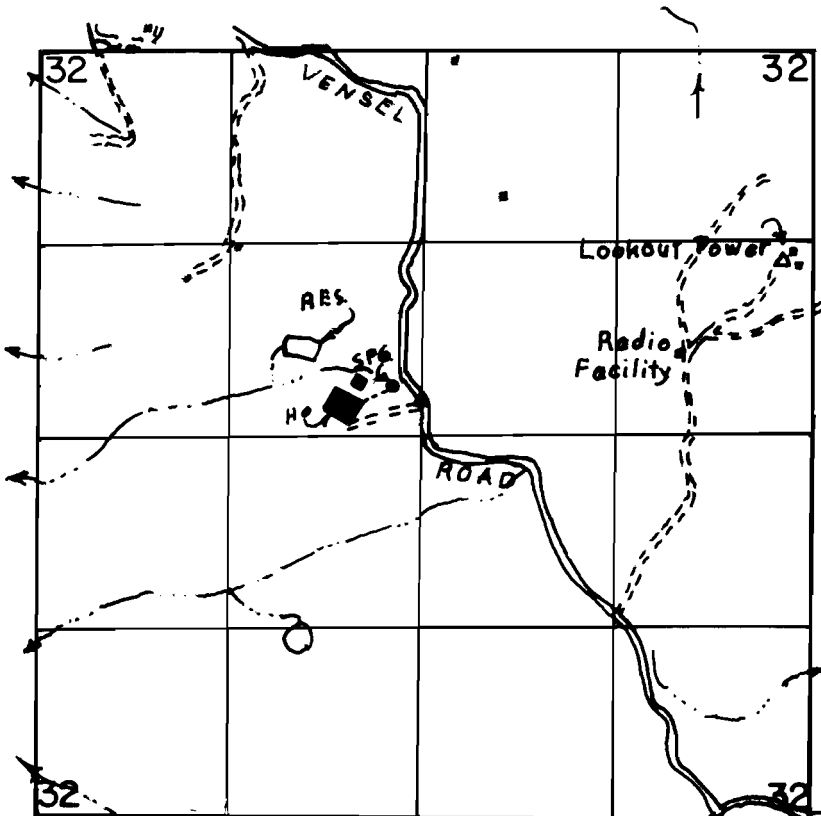

SPG. LOC: 350' N & 2425' E FROM W 1/4 COR. OF SEC 32.  
 RES. LOC: IN THE SE 1/4, NW 1/4 OF SEC 32.

SCALE: 1" = 1320'

**FINAL PROOF SURVEY**  
 UNDER

Application No. ~~R-67945~~ <sup>67946</sup> Permit No. ~~R-9895~~ <sup>48539</sup>  
 IN NAME OF

.....JILLIAN C. BARKER.....

Surveyed JULY 25 1995, by R.M. SUTTERFIELD